


LOCATION OF WATER WELL:	Fraction	Section Number	Township Number	Range Number
County: Stevens	S $\frac{1}{2}$ $\frac{1}{4}$ NE $\frac{1}{4}$ NW $\frac{1}{4}$	24	T 31 S	R 35 EW

Distance and direction from nearest town or city street address of well if located within city?

7 miles NE of Moscow, KS--

2 WATER WELL OWNER: Sweetman Drilling	Board of Agriculture, Division of Water Resources
RR#, St. Address, Box #: 110 S Main, #500	Application Number: 900547
City, State, ZIP Code: Wichita, KS 67202	

3 LOCATE WELL'S LOCATION WITH AN "X" IN SECTION BOX:	4 DEPTH OF COMPLETED WELL: 300 ft. ELEVATION:
--	---

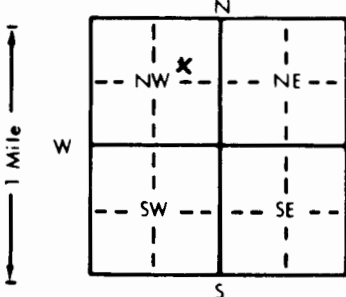

Depth(s) Groundwater Encountered 1. 150 ft. 2. ft. 3. ft.

WELL'S STATIC WATER LEVEL 150 ft. below land surface measured on mo/day/yr 11-05-90

Pump test data: Well water was 170 ft. after 1 hours pumping 100 gpm

Est. Yield 100 gpm: Well water was ft. after hours pumping gpm

Bore Hole Diameter 9 $\frac{1}{2}$ in. to 300 ft. and in. to ft.

WELL WATER TO BE USED AS:

5 Public water supply	8 Air conditioning	11 Injection well		
1 Domestic	3 Feedlot	6 Oil field water supply	9 Dewatering	12 Other (Specify below)
2 Irrigation	4 Industrial	7 Lawn and garden only	10 Monitoring well	

Was a chemical/bacteriological sample submitted to Department? Yes No X; If yes, mo/day/yr sample was submitted

Water Well Disinfected? Yes X No

5 TYPE OF BLANK CASING USED:	5 Wrought iron	8 Concrete tile	CASING JOINTS: Glued X Clamped	
1 Steel	3 RMP (SR)	6 Asbestos-Cement	9 Other (specify below)	Welded
2 PVC	4 ABS	7 Fiberglass		Threaded

Blank casing diameter 5 in. to 300 ft. Dia in. to ft. Dia in. to ft.

Casing height above land surface 24 in. weight lbs./ft. Wall thickness or gauge No. 032

TYPE OF SCREEN OR PERFORATION MATERIAL:	7 PVC	10 Asbestos-cement		
1 Steel	3 Stainless steel	5 Fiberglass	8 RMP (SR)	11 Other (specify)
2 Brass	4 Galvanized steel	6 Concrete tile	9 ABS	12 None used (open hole)

SCREEN OR PERFORATION OPENINGS ARE:	5 Gauzed wrapped	8 Saw cut	11 None (open hole)
1 Continuous slot	3 Mill slot	6 Wire wrapped	9 Drilled holes
2 Louvered shutter	4 Key punched	7 Torch cut	10 Other (specify)

SCREEN-PERFORATED INTERVALS:	From 240 ft. to 300 ft.	From ft. to ft.
GRAVEL PACK INTERVALS:	From 200 ft. to 300 ft.	From ft. to ft.

6 GROUT MATERIAL:	1 Neat cement	2 Cement grout	3 Bentonite	4 Other Hole plug
-------------------	---------------	----------------	-------------	-------------------

Grout Intervals: From 1 ft. to 20 ft.	From ft. to ft.	From ft. to ft.		
What is the nearest source of possible contamination:	10 Livestock pens	14 Abandoned water well		
1 Septic tank	4 Lateral lines	7 Pit privy	11 Fuel storage	15 Oil well/Gas well
2 Sewer lines	5 Cess pool	8 Sewage lagoon	12 Fertilizer storage	16 Other (specify below)
3 Watertight sewer lines	6 Seepage pit	9 Feedyard	13 Insecticide storage	

Direction from well? Northeast How many feet? 150

FROM	TO	LITHOLOGIC LOG	FROM	TO	PLUGGING INTERVALS
0	3	Top soil			
3	70	Clay			
70	86	Sand and Gravel			
86	92	Yellow Clay			
92	127	Sand			
127	149	Clay			
149	156	Gravel			
156	161	Clay			
161	186	Sand and Gravel			
186	195	Clay			
195	248	Sand and Gravel			
248	256	Clay			
256	264	Sand and Gravel			
264	270	Clay			
270	300	Sand and Gravel			

7 CONTRACTOR'S OR LANDOWNER'S CERTIFICATION: This water well was (1) constructed, (2) reconstructed, or (3) plugged under my jurisdiction and was completed on (mo/day/year) 11-05-90 and this record is true to the best of my knowledge and belief. Kansas Water Well Contractor's License No. KWWCL-430 This Water Well Record was completed on (mo/day/yr) 11-05-90 under the business name of Howard Drlg.Co. Box 806 Beaver, OK 73932 by (signature)
--