


1 LOCATION OF WATER WELL: County: **Stevens** Fraction: **NW 1/4 NE 1/4 NW 1/4** Section Number: **35** Township Number: **T 31 S** Range Number: **R 35 EW**
 Distance and direction from nearest town or city street address of well if located within city? **From Woods go 10 mi North 1 mi East 660' South 660' West into location.**

2 WATER WELL OWNER: **Wilbur White** **Mobil Oil Corp.**
 RR#, St. Address, Box #: **Moscow, Kansas 67952** Board of Agriculture, Division of Water Resources
 City, State, ZIP Code: **Moscow, Kansas 67952** Application Number: **T 87-8**

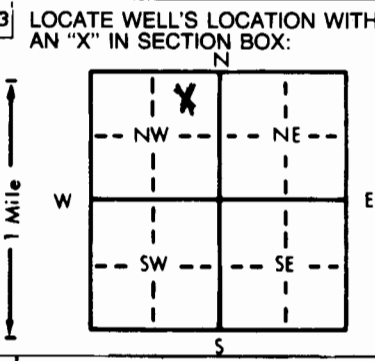

4 DEPTH OF COMPLETED WELL: **440** ft. ELEVATION: _____
 Depth(s) Groundwater Encountered 1. **151** ft. 2. _____ ft. 3. _____ ft.
 WELL'S STATIC WATER LEVEL: **299** ft. below land surface measured on mo/day/yr **1/20/87**
 Pump test data: Well water was _____ ft. after _____ hours pumping _____ gpm
 Est. Yield: **100** gpm; Well water was _____ ft. after _____ hours pumping _____ gpm
 Bore Hole Diameter: **11** in. to **440** ft., and _____ in. to _____ ft.
 WELL WATER TO BE USED AS:
 5 Public water supply 8 Air conditioning 11 Injection well
 1 Domestic 3 Feedlot 6 Oil field water supply 9 Dewatering 12 Other (Specify below)
 2 Irrigation 4 Industrial 7 Lawn and garden only 10 Observation well
 Was a chemical/bacteriological sample submitted to Department? Yes _____ No _____; If yes, mo/day/yr sample was submitted _____
 Water Well Disinfected? Yes _____ No _____

5 TYPE OF BLANK CASING USED:
 1 Steel 3 RMP (SR) 5 Wrought iron 8 Concrete tile CASING JOINTS: Glued _____ Clamped _____
 2 PVC 4 ABS 6 Asbestos-Cement 9 Other (specify below) Welded _____
 7 Fiberglass _____ Threaded _____
 Blank casing diameter: **6 5/8** in. to **320** ft., Dia. _____ in. to _____ ft., Dia. _____ in. to _____ ft.
 Casing height above land surface: **28** in., weight **2.85** lbs./ft. Wall thickness or gauge No. **265**
 TYPE OF SCREEN OR PERFORATION MATERIAL:
 1 Steel 3 Stainless steel 5 Fiberglass 7 PVC 10 Asbestos-cement
 2 Brass 4 Galvanized steel 6 Concrete tile 8 RMP (SR) 11 Other (specify) _____
 9 ABS 12 None used (open hole)
 SCREEN OR PERFORATION OPENINGS ARE:
 1 Continuous slot 5 Gauzed wrapped 8 Saw cut 11 None (open hole)
 2 Louvered shutter 3 Mill slot 6 Wire wrapped 9 Drilled holes
 4 Key punched 7 Torch cut 10 Other (specify) _____
 SCREEN-PERFORATED INTERVALS: From **320** ft. to **440** ft., From _____ ft. to _____ ft.
 From _____ ft. to _____ ft., From _____ ft. to _____ ft.
 GRAVEL PACK INTERVALS: From **260** ft. to **440** ft., From _____ ft. to _____ ft.
 From _____ ft. to _____ ft., From _____ ft. to _____ ft.

6 GROUT MATERIAL: 1 Neat cement 2 Cement grout 3 Bentonite 4 Other _____
 Grout Intervals: From **0** ft. to **10** ft., From _____ ft. to _____ ft., From _____ ft. to _____ ft.
 What is the nearest source of possible contamination:
 1 Septic tank 4 Lateral lines 7 Pit privy 10 Livestock pens 14 Abandoned water well
 2 Sewer lines 5 Cess pool 8 Sewage lagoon 11 Fuel storage 15 Oil well/Gas well
 3 Watertight sewer lines 6 Seepage pit 9 Feedyard 12 Fertilizer storage 16 Other (specify below)
 13 Insecticide storage
 Direction from well? **Southeast of water well** How many feet? **225'**

FROM	TO	LITHOLOGIC LOG	FROM	TO	LITHOLOGIC LOG
0	2	surface			
2	128	clay			
128	143	med. to large sand			
143	161	clay			
161	248	med. to large sand			
248	253	45% clay, 35% fine sand & 20% gravel			
253	262	med. sand			
262	308	sandy clay			
308	383	med. to lg. sand			
383	395	40% clay, 40% fine sand & 20% med. sand			
395	427	med. sand			
427	440	50% clay & 50% gravel			

7 CONTRACTOR'S OR LANDOWNER'S CERTIFICATION: This water well was (1) constructed, (2) reconstructed, or (3) plugged under my jurisdiction and was completed on (mo/day/year) **January 20, 1987** and this record is true to the best of my knowledge and belief. Kansas Water Well Contractor's License No. **118** This Water Well Record was completed on (mo/day/yr) **January 28, 1987** under the business name of **Carlile Water Well Service, Inc.** by (signature) _____

OFFICE USE ONLY T R EW SEC