

1 LOCATION OF WATER WELL: Fraction Section Number Township Number Range Number
 County: Stevens SW 1/4 NE 1/4 NE 1/4 24 T 31 S R 35 EW

Distance and direction from nearest town or city street address of well if located within city?

7E of Moscow, KS--

2 WATER WELL OWNER: Mobil Corp.

#1-3 Ralph Lowe

RR#, St. Address, Box #: Box 2173


Board of Agriculture, Division of Water Resources

City, State, ZIP Code: Liberal, KS 67905

Application Number: 930364

3 LOCATE WELL'S LOCATION WITH AN "X" IN SECTION BOX:

4 DEPTH OF COMPLETED WELL: 300 ft. ELEVATION:

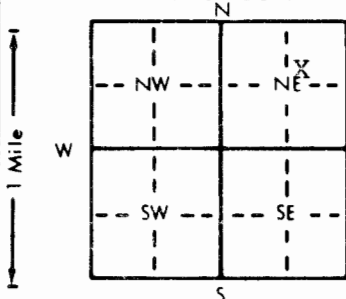

Depth(s) Groundwater Encountered 1. ft. 2. ft. 3. ft.

WELL'S STATIC WATER LEVEL 170 ft. below land surface measured on mo/day/yr 2/23/94

Pump test data: Well water was ft. after hours pumping gpm

Est. Yield gpm: Well water was ft. after hours pumping gpm

Bore Hole Diameter in. to ft. and in. to ft.

WELL WATER TO BE USED AS: 5 Public water supply 8 Air conditioning 11 Injection well

1 Domestic 3 Feedlot 6 Oil field water supply 9 Dewatering 12 Other (Specify below)

2 Irrigation 4 Industrial 7 Lawn and garden only 10 Monitoring well

Was a chemical/bacteriological sample submitted to Department? Yes No If yes, mo/day/yr sample was submitted

Water Well Disinfected? Yes No

5 TYPE OF BLANK CASING USED:

5 Wrought iron

8 Concrete tile

CASING JOINTS: Glued Clamped

1 Steel

3 RMP (SR)

6 Asbestos-Cement

9 Other (specify below)

Welded

2 PVC

4 ABS

7 Fiberglass

Threaded

Blank casing diameter 6 in. to 300 ft. Dia in. to ft. Dia in. to ft.

Casing height above land surface 5 ft. below in. weight lbs./ft. Wall thickness or gauge No.

TYPE OF SCREEN OR PERFORATION MATERIAL:

7 PVC

10 Asbestos-cement

1 Steel

3 Stainless steel

5 Fiberglass

8 RMP (SR)

11 Other (specify) NA

2 Brass

4 Galvanized steel

6 Concrete tile

9 ABS

12 None used (open hole)

SCREEN OR PERFORATION OPENINGS ARE:

5 Gauzed wrapped

8 Saw cut

11 None (open hole)

1 Continuous slot

3 Mill slot

6 Wire wrapped

9 Drilled holes

2 Louvered shutter

4 Key punched

7 Torch cut

10 Other (specify) NA

SCREEN-PERFORATED INTERVALS: From NA ft. to NA ft. From ft. to ft. From ft. to ft. From ft. to ft.

GRAVEL PACK INTERVALS: From ft. to ft. From ft. to ft. From ft. to ft. From ft. to ft.

6 GROUT MATERIAL:

1 Neat cement

2 Cement grout

3 Bentonite

4 Other

Grout Intervals: From 8 ft. to 5 ft. From ft. to ft. From ft. to ft. From ft. to ft.

What is the nearest source of possible contamination:

1 Septic tank

4 Lateral lines

7 Pit privy

10 Livestock pens

14 Abandoned water well

2 Sewer lines

5 Cess pool

8 Sewage lagoon

11 Fuel storage

15 Oil well/Gas well

3 Watertight sewer lines

6 Seepage pit

9 Feedyard

12 Fertilizer storage

16 Other (specify below)

13 Insecticide storage

Direction from well?

Southwest

How many feet? 390

FROM	TO	LITHOLOGIC LOG	FROM	TO	PLUGGING INTERVALS
			300	150	Chlorinated Gravel
			150	140	Bentonite Grout
			140	28	Chlorinated Gravel
			28	8	Bentonite Grout
			8	5	Cement Grout
			5	0	Backfill

7 CONTRACTOR'S OR LANDOWNER'S CERTIFICATION: This water well was (1) constructed, (2) reconstructed, or (3) plugged under my jurisdiction and was

completed on (mo/day/year) 2/23/94 and this record is true to the best of my knowledge and belief. Kansas

Water Well Contractor's License No. KWWCL-430

This Water Well Record was completed on (mo/day/yr) 2/23/94

under the business name of Howard Drig. Co. Box 806 Beaver, OK 73932 by (signature) *Alia Howard*