

1 LOCATION OF WATER WELL: County: **STEVENS** Fraction: **NW 1/4 NW 1/4 SE 1/4** Section Number: **14** Township Number: **T 31 S** Range Number: **R 36W E/W**


Distance and direction from nearest town or city street address of well if located within city?

**1 1/2 MILES NORTH OF MOSCOW, KS**

2 WATER WELL OWNER: **BEREDCO INC.** RR#, St. Address, Box #: **100 N BROADWAY STE. 970** City, State, ZIP Code: **WICHITA, KS 67202-2209**

#2-14 CLARETTA  
Board of Agriculture, Division of Water Resources  
Application Number:

3 LOCATE WELL'S LOCATION WITH AN "X" IN SECTION BOX: 4 DEPTH OF COMPLETED WELL: **460** ft. ELEVATION:

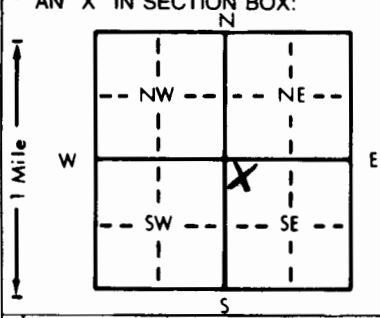

Depth(s) Groundwater Encountered 1. . . . . ft. 2. . . . . ft. 3. . . . . ft.

WELL'S STATIC WATER LEVEL: **240** ft. below land surface measured on mo/day/yr **12-14-95**

Pump test data: Well water was . . . . . ft. after . . . . . hours pumping . . . . . gpm

Est. Yield . . . . . gpm: Well water was . . . . . ft. after . . . . . hours pumping . . . . . gpm

Bore Hole Diameter . . . . . in. to . . . . . ft., and . . . . . in. to . . . . . ft.

WELL WATER USED AS:

<input checked="" type="checkbox"/> 1 Domestic	<input checked="" type="checkbox"/> 3 Feedlot	<input checked="" type="checkbox"/> 5 Public water supply	<input type="checkbox"/> 8 Air conditioning	<input type="checkbox"/> 11 Injection well
<input type="checkbox"/> 2 Irrigation	<input type="checkbox"/> 4 Industrial	<input checked="" type="checkbox"/> 7 Lawn and garden only	<input type="checkbox"/> 9 Dewatering	<input type="checkbox"/> 12 Other (Specify below)

Was a chemical/bacteriological sample submitted to Department? Yes . . . . . No . . . . . ; If yes, mo/day/yr sample was submitted

Water Well Disinfected? Yes . . . . . No

5 TYPE OF BLANK CASING USED:

<input checked="" type="checkbox"/> 1 Steel	<input type="checkbox"/> 3 RMP (SR)	<input type="checkbox"/> 5 Wrought iron	<input type="checkbox"/> 8 Concrete tile	CASING JOINTS: Glued . . . . . Clamped . . . . .
<input checked="" type="checkbox"/> 2 PVC	<input type="checkbox"/> 4 ABS	<input type="checkbox"/> 6 Asbestos-Cement	<input type="checkbox"/> 9 Other (specify below)	Welded . . . . .
		<input type="checkbox"/> 7 Fiberglass		Threaded . . . . .

Blank casing diameter: **5** in. to **460** ft. Dia. . . . . in. to . . . . . ft. Dia. . . . . in. to . . . . . ft.

Casing height above land surface: **5' BELOW** in., weight . . . . . lbs./ft. Wall thickness or gauge No. . . . .

TYPE OF SCREEN OR PERFORATION MATERIAL:

<input type="checkbox"/> 1 Steel	<input type="checkbox"/> 3 Stainless steel	<input type="checkbox"/> 5 Fiberglass	<input type="checkbox"/> 7 PVC	<input type="checkbox"/> 10 Asbestos-cement
<input type="checkbox"/> 2 Brass	<input type="checkbox"/> 4 Galvanized steel	<input type="checkbox"/> 6 Concrete tile	<input type="checkbox"/> 8 RMP (SR)	<input type="checkbox"/> 11 Other (specify)
			<input type="checkbox"/> 9 ABS	<input type="checkbox"/> 12 None used (open hole)

SCREEN OR PERFORATION OPENINGS ARE:

<input type="checkbox"/> 1 Continuous slot	<input type="checkbox"/> 3 Mill slot	<input type="checkbox"/> 5 Gauzed wrapped	<input type="checkbox"/> 8 Saw cut	<input type="checkbox"/> 11 None (open hole)
<input type="checkbox"/> 2 Louvered shutter	<input type="checkbox"/> 4 Key punched	<input type="checkbox"/> 6 Wire wrapped	<input type="checkbox"/> 9 Drilled holes	
		<input type="checkbox"/> 7 Torch cut	<input type="checkbox"/> 10 Other (specify)	

SCREEN-PERFORATED INTERVALS: From . . . . . ft. to . . . . . ft., From . . . . . ft. to . . . . . ft.

GRAVEL PACK INTERVALS: From . . . . . ft. to . . . . . ft., From . . . . . ft. to . . . . . ft.

6 GROUT MATERIAL:  1 Neat cement  2 Cement grout  3 Bentonite  4 Other

Grout Intervals: From **8** ft. to **5** ft., From . . . . . ft. to . . . . . ft.

What is the nearest source of possible contamination:

<input type="checkbox"/> 1 Septic tank	<input type="checkbox"/> 4 Lateral lines	<input type="checkbox"/> 7 Pit privy	<input type="checkbox"/> 10 Livestock pens	<input type="checkbox"/> 14 Abandoned water well
<input type="checkbox"/> 2 Sewer lines	<input type="checkbox"/> 5 Cess pool	<input type="checkbox"/> 8 Sewage lagoon	<input type="checkbox"/> 11 Fuel storage	<input checked="" type="checkbox"/> 15 Oil well/Gas well
<input type="checkbox"/> 3 Watertight sewer lines	<input type="checkbox"/> 6 Seepage pit	<input type="checkbox"/> 9 Feedyard	<input type="checkbox"/> 12 Fertilizer storage	<input type="checkbox"/> 16 Other (specify below)

Direction from well? **east** How many feet? **200**

FROM	TO	LITHOLOGIC LOG	FROM	TO	PLUGGING INTERVALS
			360	225	CHLORINATED GRAVEL
			225	210	HOLE PLUG
			210	5	CEMENT GROUT
			5	0	BACKFILL

7 CONTRACTOR'S OR LANDOWNER'S CERTIFICATION: This water well was (1) constructed, (2) reconstructed, or (3) plugged under my jurisdiction and was completed on (mo/day/year) **12-14-95** and this record is true to the best of my knowledge and belief. Kansas Water Well Contractor's License No. **KWCL-430**. This Water Well Record was completed on (mo/day/yr) **12-14-95** under the business name of **HOWARD DRLG. CO. BOX 806 BEAVER, OK 73932** by (signature) *Howard*

INSTRUCTIONS: Use typewriter or ball point pen. PLEASE PRESS FIRMLY and PRINT clearly. Please fill in blanks, underline or circle the correct answers. Send top three copies to Kansas Department of Health and Environment, Bureau of Water, Topeka, Kansas 66620-0001. Telephone: 913-296-5545. Send one to WATER WELL OWNER and retain one for your records.