


1 LOCATION OF WATER WELL: County: **Stevens** Fraction: **NW 1/4 SE 1/4 NW 1/4** Section Number: **4** Township Number: **T 31 S** Range Number: **R 36 E/W**

Distance and direction from nearest town or city street address of well if located within city?
4 1/2 N., of Moscow on B/T 2W., .3S., E into

2 WATER WELL OWNER: **Sweetman Drilling** #1-4 Grigsby "A"
 RR#, St. Address, Box #: **3017 N Cypress** Board of Agriculture, Division of Water Resources
 City, State, ZIP Code: **Wichita, Ks 67226-4003** Application Number: **970388**

3 LOCATE WELL'S LOCATION WITH AN "X" IN SECTION BOX:

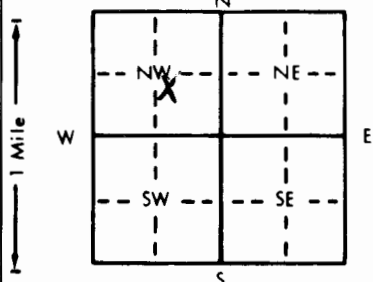

4 DEPTH OF COMPLETED WELL: **440** ft. ELEVATION: _____
 Depth(s) Groundwater Encountered 1. **210** ft. 2. _____ ft. 3. _____ ft.
 WELL'S STATIC WATER LEVEL: **210** ft. below land surface measured on mo/day/yr **9-13-97**
 Pump test data: Well water was **273** ft. after **1** hours pumping **100** gpm
 Est. Yield **100** gpm: Well water was _____ ft. after _____ hours pumping _____ gpm
 Bore Hole Diameter: **11** in. to **440** ft., and _____ in. to _____ ft.
 WELL WATER TO BE USED AS:
 1 Domestic 3 Feedlot **6** Oil field water supply 9 Dewatering 11 Injection well
 2 Irrigation 4 Industrial 7 Lawn and garden only 10 Monitoring well
 Was a chemical/bacteriological sample submitted to Department? Yes _____ No **X** If yes, mo/day/yr sample was submitted
 Water Well Disinfected? Yes **X** No

5 TYPE OF BLANK CASING USED:
 1 Steel 3 RMP (SR) 5 Wrought iron 8 Concrete tile CASING JOINTS: Glued **X** Clamped _____
2 PVC 4 ABS 6 Asbestos-Cement 9 Other (specify below) Welded _____
 7 Fiberglass Threaded _____
 Blank casing diameter **6** in. to **440** ft., Dia _____ in. to _____ ft., Dia _____ in. to _____ ft.
 Casing height above land surface: **24** in., weight **2.902** lbs./ft. Wall thickness or gauge No. **.281 SDR 21**

TYPE OF SCREEN OR PERFORATION MATERIAL:
 1 Steel 3 Stainless steel 5 Fiberglass **7** PVC 10 Asbestos-cement
 2 Brass 4 Galvanized steel 6 Concrete tile 8 RMP (SR) 11 Other (specify) _____
 9 ABS 12 None used (open hole)
 SCREEN OR PERFORATION OPENINGS ARE:
 1 Continuous slot 3 Mill slot 5 Gauzed wrapped **8** Saw cut 11 None (open hole)
 2 Louvered shutter 4 Key punched 6 Wire wrapped 9 Drilled holes
 7 Torch cut 10 Other (specify) _____
 SCREEN-PERFORATED INTERVALS: From **280** ft. to **440** ft., From _____ ft. to _____ ft.
 From _____ ft. to _____ ft., From _____ ft. to _____ ft.
 GRAVEL PACK INTERVALS: From **240** ft. to **440** ft., From _____ ft. to _____ ft.
 From _____ ft. to _____ ft., From _____ ft. to _____ ft.

6 GROUT MATERIAL: **1** Neat cement 2 Cement grout 3 Bentonite **4** Other **Hole Plug**
 Grout Intervals: From **0** ft. to **20** ft., From _____ ft. to _____ ft., From _____ ft. to _____ ft.
 What is the nearest source of possible contamination:
 1 Septic tank 4 Lateral lines 7 Pit privy 10 Livestock pens 14 Abandoned water well
 2 Sewer lines 5 Cess pool 8 Sewage lagoon 11 Fuel storage **15** Oil well/Gas well
 3 Watertight sewer lines 6 Seepage pit 9 Feedyard 12 Fertilizer storage 16 Other (specify below)
 Direction from well? **Southeast** How many feet? **250**

FROM	TO	LITHOLOGIC LOG	FROM	TO	PLUGGING INTERVALS
0	3	Surface			
3	92	Clay			
92	196	Sand			
196	217	Clay			
217	285	Clay & Sand Streaks			
285	311	Sand & Clay Streaks			
311	371	Clay			
371	420	Fine Sand			
420	440	Clay			

7 CONTRACTOR'S OR LANDOWNER'S CERTIFICATION: This water well was **(1)** constructed, (2) reconstructed, or (3) plugged under my jurisdiction and was completed on (mo/day/year) **9-13-97** and this record is true to the best of my knowledge and belief. Kansas Water Well Contractor's License No. **KWWCL - 430** This Water Well Record was completed on (mo/day/yr) **9-13-97** under the business name **Howard Drlg. Box 806 Beaver, Ok 73932** by (signature) *[Signature]*