


1 LOCATION OF WATER WELL: County: Stevens Fraction: NE 1/4 SW 1/4 NW 1/4 Section Number: 26 Township Number: T 31 S Range Number: R 36 EW

Distance and direction from nearest town or city street address of well if located within city?

2 WATER WELL OWNER: Collingwood Grain Board of Agriculture, Division of Water Resources
 RF#, St. Address, Box #: Moscow, KS. Application Number: MW#4
 City, State, ZIP Code: Moscow, KS.

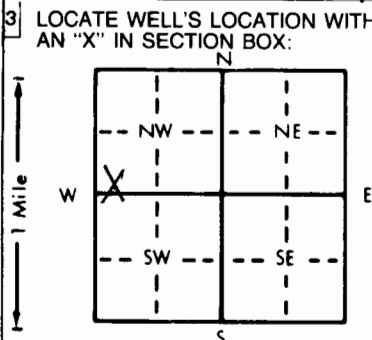

4 DEPTH OF COMPLETED WELL: 270 ft. ELEVATION: _____
 Depth(s) Groundwater Encountered 1. _____ ft. 2. _____ ft. 3. _____ ft.
 WELL'S STATIC WATER LEVEL: 202 ft. below land surface measured on mo/day/yr
 Pump test data: Well water was _____ ft. after _____ hours pumping _____ gpm
 Est. Yield _____ gpm: Well water was _____ ft. after _____ hours pumping _____ gpm
 Bore Hole Diameter: 8 in. to 270 ft., and _____ in. to _____ ft.
 WELL WATER TO BE USED AS:
 5 Public water supply 8 Air conditioning 11 Injection well
 1 Domestic 3 Feedlot 6 Oil field water supply 9 Dewatering 12 Other (Specify below)
 2 Irrigation 4 Industrial 7 Lawn and garden only 10 Monitoring well
 Was a chemical/bacteriological sample submitted to Department? Yes _____ No X; If yes, mo/day/yr sample was submitted _____
 Water Well Disinfected? Yes _____ No X

5 TYPE OF BLANK CASING USED:
 1 Steel 3 RMP (SR) 5 Wrought iron 8 Concrete tile CASING JOINTS: Glued _____ Clamped _____
 2 PVC 4 ABS 6 Asbestos-Cement 9 Other (specify below) Welded _____
 7 Fiberglass Threaded: SS screws
 Blank casing diameter: 4.5 in. to 150 ft. Dia. _____ in. to _____ ft. Dia. _____ in. to _____ ft.
 Casing height above land surface: 0 in., weight: 2.38 lbs./ft. Wall thickness or gauge No. 248
 TYPE OF SCREEN OR PERFORATION MATERIAL:
 1 Steel 3 Stainless steel 5 Fiberglass 7 PVC 10 Asbestos-cement
 2 Brass 4 Galvanized steel 6 Concrete tile 8 RMP (SR) 11 Other (specify) _____
 9 ABS 12 None used (open hole)
 SCREEN OR PERFORATION OPENINGS ARE:
 1 Continuous slot 3 Mill slot 5 Gauzed wrapped 8 Saw cut 11 None (open hole)
 2 Louvered shutter 4 Key punched 6 Wire wrapped 9 Drilled holes
 7 Torch cut 10 Other (specify) _____
 SCREEN-PERFORATED INTERVALS: From _____ ft. to _____ ft., From _____ ft. to _____ ft.
 GRAVEL PACK INTERVALS: From _____ ft. to _____ ft., From _____ ft. to _____ ft.

6 GROUT MATERIAL: 1 Neat cement 2 Cement grout 3 Bentonite 4 Other _____
 Grout Intervals: From _____ ft. to 260 ft., From 260 ft. to 270 ft., From _____ ft. to _____ ft.
 What is the nearest source of possible contamination:
 1 Septic tank 4 Lateral lines 7 Pit privy 10 Livestock pens 14 Abandoned water well
 2 Sewer lines 5 Cess pool 8 Sewage lagoon 11 Fuel storage 15 Oil well/Gas well
 3 Watertight sewer lines 6 Seepage pit 9 Feedyard 12 Fertilizer storage 16 Other (specify below)
 13 Insecticide storage Contaminated site
 Direction from well? _____ How many feet? _____

FROM	TO	LITHOLOGIC LOG	FROM	TO	PLUGGING INTERVALS
0	8	Rocks	210	213	Cemented sand
8	10	Loess	213	219	Sandy clay & sand strks
10	40	clay & caliche	219	232	sandy clay w/ caliche
40	56	fine sand w/ clay lenses	232	235	caliche
56	135	clay & caliche	235	245	sandy clay & fine sand
135	140	Cemented sand w/ clay & caliche	245	251	fine to med sand w/ clay lenses
140	145	fine to med sand w/ clay	251	260	fine sand & sandy clay w/ caliche str
145	154	Cemented sand w/ clay & sand strks	260	270	loose fine sand w/ clay strks
154	176	Semi-tight fine to med sand w/ clay			
176	179.5	sandy clay w/ caliche			
179.5	181	Semi-tight fine to med sand w/ clay			
181	190	sandy clay w/ caliche			
190	199	fine to med sand w/ clay & cemented sand strks			
199	210	sandy clay & sand strks			

7 CONTRACTOR'S OR LANDOWNER'S CERTIFICATION: This water well was (1) constructed, (2) reconstructed, or (3) plugged under my jurisdiction and was completed on (mo/day/year) 12-13-97 and this record is true to the best of my knowledge and belief. Kansas Water Well Contractor's License No. 554 This Water Well Record was completed on (mo/day/yr) 1-19-98 under the business name of Woolter Pump & Well, Inc. by (signature) Gayle Woolter

OFFICE USE ONLY T R EW SEC