

USE TYPEWRITER OR BALL POINT PEN-PRESS FIRMLY, PRINT CLEARLY.

T R EW sec 1/4 1/4 1/4 No.


WATER WELL RECORD
KSA 82a-1201-1215

Kansas State Dept. Of Health
(Water Well Contractors)
Forbes-Bldg. 740
Topeka, Kansas 66620

1 Location of well:	County Stevens	Township name	Fraction SE$\frac{1}{4}$ SE$\frac{1}{4}$ NE$\frac{1}{4}$	Section number 10	Town number 31S	Range number 35W 36W
---------------------	--------------------------	---------------	---	-----------------------------	---------------------------	--------------------------------

Distance and direction from nearest town or city: **from Hickok Ks. 1 mile east, 13 $\frac{1}{2}$ miles south**
Street address of well location if in city:

3 Owner of well: **Mrs. O. T. Gilbert**
Address: **Moscow, Kansas**

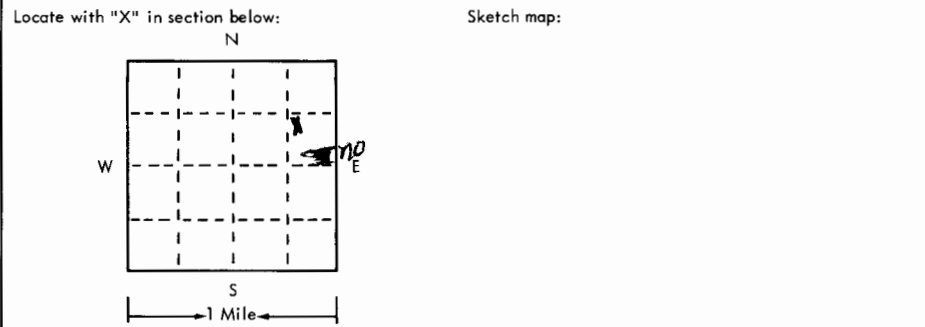

4 Well depth: **514** ft. Date of completion **7/7/75**
Well diameter: **27** in.

5 Cable tool Rotary Driven Dug
 Hollow rod Jetted Bored Reverse rotary

6 Use: Domestic Public supply Industry
 Irrigation Air conditioning Commercial
 Test well

7 Casing: Material **stl** Height: **above/below**
Threaded Welded Surface **12** in.
Diam. **16"** Weight **36.8** lbs./ft. **1**
0 in. to **262.9** ft. depth Drive shoe? Yes No
0 in. to **0** ft. depth!

2	Type and color of material	From	To
	Surface	0	2
	Brown clay	2	109
	Fine to medium sand w/cemented strips & clay breakers	109	220
	Brown clay w/fine sand strips	220	260
	Fine to medium & coarse sand w/clay breakers 32ft	260	320
	Brown clay w/fine sand strips	320	335
	Brown clay w/sand strips	335	387
	Brown & red clay w/sandstone strips	387	420
	Brown clay w/sandstone strips 22 ft.	420	510
	Brown clay	510	520
	(use a second sheet if needed)		

8 Screen: **Lakewood**
Manufacturer **Lakewood**
Type **stl** Dia. **16"**
Slot/gauze **3/16** Length **2" slot**
Set between **262.9** ft. and **514** ft.
Fittings:
Gravel pack Yes No Size range of material **---**

9 Static water level:
166 ft. below land surface Date **6-29-75**

10 Pumping level below land surfaces:
____ ft. after ____ hrs. pumping ____ g.p.m.
395 ft. after **39** hrs. pumping **900** g.p.m.
Estimated maximum yield **900** g.p.m.

11 Water sample submitted:
 Yes No Date _____

12 Well head completion:
 Pitless adapter **10** Inches above grade

13 Well grouted? Yes No
 Neat cement Bentonite _____
Depth: From **0** ft. to **10** ft.

14 Nearest source of possible contamination:
ft. **1000** Direction **NW** Type **House**
Well disinfected upon completion? Yes No

15 Pump: Not installed
Manufacturer's name _____
Model number _____ HP _____ Volts _____
Length of drop pipe _____ ft. capacity _____ g.m.p.
Type:
 Submersible Turbine
 Jet Reciprocating
 Centrifugal Other

16 Remarks: elevation

Topography:
 Hill
 Slope
 Upland
 Valley

17 Water well contractor's certification:
This well was drilled under my jurisdiction and this report is true to the best of my knowledge and belief.
Houck Bros. Drlg. Co. 164
Business name **Box 487, Ulysses, Kas 1**
Address _____
Signed **M. Beard** Date **7/15/75**
Authorized representative