


USE TYPEWRITER OR BALL POINT PEN-PRESS FIRMLY, PRINT CLEARLY.

WATER WELL RECORD
KSA 82a-1201-1215

Kansas Department of Health and Environment-Division of Environment (Water well Contractors) Topeka, Kansas 66620

1. Location of well: County Stevens Fraction NW 1/4 NW 1/4 NE 1/4 Section number 23 Township number T 31 S R 36 Range number EW

2. Distance and direction from nearest town or city: 2 1/2 W Street address of well location if in city: Moscow 3. Owner of well: Jim Teeter R.R. City, state, zip code: Moscow, Kansas 67952

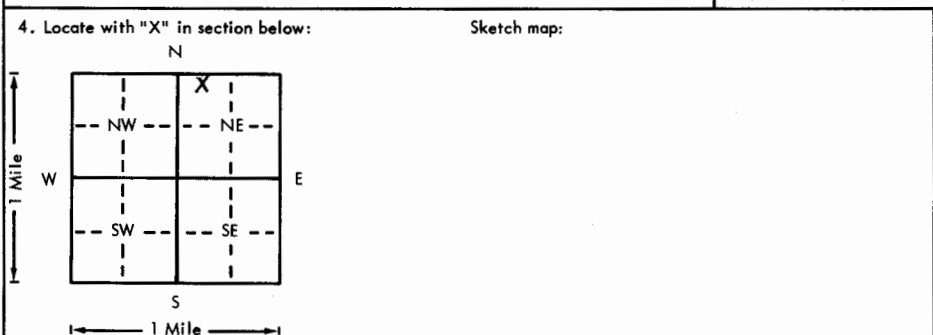

6. Bore hole dia. 10 in. Completion date 3-22-76 Well depth 292 ft.

7. Cable tool Rotary Driven Dug Hollow rod Jetted Bored Reverse rotary

8. Use: Domestic Public supply Industry Irrigation Air conditioning Stock Lawn Oil field water Other

Casing: Material Height: Above or below Threaded Welded Surface 12 in. RMP PVC Weight 2.75 lbs./ft. Dia. 5 in. to 292 ft. depth Wall Thickness: inches or Dia. 5 in. to 292 ft. depth gage No. 250

5. Type and color of material	From	To
<u>18" Top soil light gray</u>		
<u>sandy to tight tan sandy</u>	<u>1.6</u>	<u>20</u>
<u>brown silts w/ some fine sand & grit</u>	<u>20</u>	<u>48</u>
<u>Clay balls - brown w/ silt</u>	<u>48</u>	<u>68</u>
<u>sand brown + coarse w/ dark gravel</u>	<u>68</u>	<u>90</u>
<u>clay balls brown w/ gravel large</u>	<u>90</u>	<u>100</u>
<u>clay tan w/ sand + gravel</u>	<u>100</u>	<u>152</u>
<u>sand brown coarse w/ clay balls</u>	<u>152</u>	<u>212</u>
<u>clay shelf brown w/ some gravel</u>	<u>212</u>	<u>220</u>
<u>sand coarse w/ brown clay balls</u>	<u>220</u>	<u>272</u>
<u>clays w/ sand coarse to medium</u>	<u>272</u>	<u>292</u>
<u>clays</u>	<u>292</u>	<u>300</u>

10. Screen: Manufacturer's name Pumpco

Type Sch HO Dia. 5 Slot/gauze 1/2" saw cut Length 20' Set between 272 ft. and 292 ft. Gravel pack? Size range of material 4-1/2"

11. Static water level: 165 ft. below land surface Date 3-22-76 mo./day/yr.

12. Pumping level below land surfaces: 177 ft. after 2 hrs. pumping 20 g.p.m. Estimated maximum yield 1.66 gal. per ft. draw

13. Water sample submitted: Yes No Date

14. Well head completion: Pitless adapter 12 inches above grade

15. Well grouted? With: Neat cement Bentonite Concrete Depth: From 3 ft. to 13 ft.

16. Nearest source of possible contamination: ? Well disinfected upon completion? Yes No

17. Pump: Not installed Manufacturer's name Pumpco Model number 1525/1515 HP 1 1/2 Volts 230 Length of drop pipe 200 ft. capacity 20 g.p.m. Type: Submersible Turbine Jet Reciprocating Centrifugal Other

18. Elevation: Topography: Hill Slope Upland Valley 19. Remarks:

20. Water well contractor's certification: This well was drilled under my jurisdiction and this report is true to the best of my knowledge and belief. Slocum Well Drilling 127 A Business name License No. Address HUGOTON KANSAS Signed Paul Slocum Date 3-27 Authorized representative

37 36 W 23 NW 1/4