USE TYPEWRITER OR BALL POINT PEN-PRESS FIRMLY, PRINT CLEARLY.

T R EW sec 1/4 1/4 1/4 No.

WATER WELL RECORD
KSA 82a-1201-1215

Kansas State Dept. Of Health
(Water Well Contractors)
Forbes-Bldg. 740
Topeka, Kansas 66620

1 Location of well:	County	Township name	Fraction	Section number	Town number	Range number
	Stevens		Null SW¼	25	T 31 S	R 36 W

Distance and direction from nearest town or city: 3 miles SE of
Street address of well location if in city: Moscow, Kansas

3 Owner of well: Carl N. Brollier
Address: Moscow, Kansas

Locate with "X" in section below:

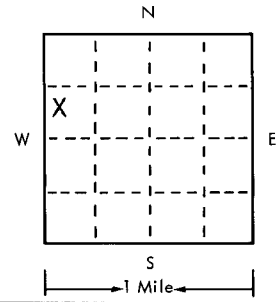

Sketch map:

4 Well depth: 500 ft. Date of completion 2/21/75
Well diameter 28 in.

5 ☐ Cable tool ☒ Rotary ☐ Driven ☐ Dug ☐ Hollow rod ☐ Jetted ☐ Bored ☐ Reverse rotary

6 Use: ☐ Domestic ☐ Public supply ☐ Industry ☒ Irrigation ☐ Air conditioning ☐ Commercial ☐ Test well ☐ _____

7 Casing: Material Steel Height: (above)/below
Threaded ☐ Welded ☒ Surface 12 in.
Diam. 16 in. to 500 ft. depth Weight _____ lbs./ft.
Drive shoe? ☐ Yes ☒ No
_____ in. to _____ ft. depth

2 Type and color of material	From	To
Overburden	0	180
Brown clay and sand streaks	180	260
Sand and shale	260	400
Med. to coarse sand with shale streaks	400	460
Sand and gravel, pink clay to red bed	460	500
(use a second sheet if needed)		

8 Screen: Perforation
Manufacturer W.A. Brown
Type .219 Dia. 16"
Slot/gauze 6% flow Length 260
Set between 240 ft. and 500 ft.
Fittings: ½ down
Gravel pack ☒ Yes ☐ No Size range of material _____

9 Static water level:
196 ft. below land surface Date 3/17/75

10 Pumping level below land surfaces:
440 ft. after 4 hrs. pumping 500 g.p.m.
_____ ft. after _____ hrs. pumping _____ g.p.m.
Estimated maximum yield 700 g.p.m.

11 Water sample submitted:
☐ Yes ☒ No Date _____

12 Well head completion:
☐ Pitless adapter 12 ☐ Inches above grade

13 Well grouted? ☒ Yes ☐ No
☒ Neat cement ☐ Bentonite ☐ _____
Depth: From 0 ft. to 10 ft.

14 Nearest source of possible contamination:
ft. _____ Direction _____ Type _____
Well disinfected upon completion? ☐ Yes ☒ No

15 Pump: ☐ Not installed
Manufacturer's name Worthington
Model number 8" HP _____ Volts _____
Length of drop pipe 450 ft. capacity _____ g.m.p.
Type:
☐ Submersible ☒ Turbine
☐ Jet ☐ Reciprocating
☐ Certrifugal ☐ Other

16 Remarks: elevation

Topography:
☐ Hill
☐ Slope
☐ Upland
☐ Valley

17 Water well contractor's certification:
This well was drilled under my jurisdiction and this report is true to the best of my knowledge and belief.
Jones Drlg. Co. 257
Business name License No.
Address P.O. Box 187 Liberal, Ks.
Signed _____ Date _____
Authorized representative 3-18-75

Forward the white, blue and pink copies to the Kansas State Dept. Of Health.

Form WWC-5