


WATER WELL RECORD Form WWC-5 KSA 82a-1212

1 LOCATION OF WATER WELL: Fraction Section Number Township Number Range Number
 COUNTY: STEVENS SE 1/4 SE 1/4 SE 1/4 9 T 31 S R 36 W

Distance and direction from nearest town or city street address of well if located within city?
 FROM MOSCOW - 2 1/2 MILES NORTH & 1 MILE WEST

2 WATER WELL OWNER: OWENS, MIKE
 RR#, St. Address, Box #: RR #1 -- BOX 14 Board of Agriculture, Division of Water Resources
 City, State, ZIP code: MOSCOW, KS 67952- Application Number:

3 LOCATE WELL'S LOCATION WITH AN "X" IN SECTION BOX: 4 DEPTH OF COMPLETED WELL 405 ELEVATION: 0
 Depth(s) Groundwater Encountered 1. 0 ft. 2. 0 ft. 3. 0 ft.

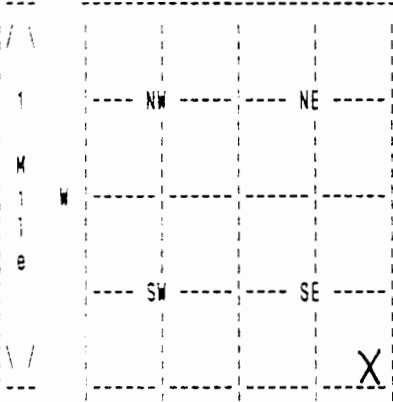

WELL'S STATIC WATER LEVEL 182 ft. below land surface measured on mo/day/yr 08/11/08
 Pump test data: Well water was 0 ft. after 0 hours pumping 0 gpm

Estimated Yield 50 gpm: Well water was 0 ft. after 0 hours pumping 0 gpm

Bore Hole Diameter 10 in. to 405 ft., and in. to 0 ft.

WELL WATER TO BE USED AS: DOMESTIC

Was a chemical/bacteriological sample submitted to department? No ;
 If yes, mo/day/yr sample was submitted Water well disinfected? Yes

5 TYPE OF BLANK CASING USED: CERTA LOC CASIN CASING JOINTS: CERTA-LOC
 Blank casing diameter 5 in. to 405 ft., Dia in. to 0 ft., Dia in. to 0 ft.
 Casing height above land surface 12 in., weight 200 lbs/ft. Wall thickness or gauge No. 21 17
 TYPE OF SCREEN OR PERFORATION MATERIAL: PVC
 SCREEN OR PERFORATION OPENINGS ARE: SAW CUT

SCREEN PERFORATED INTERVALS: From 240 ft. to 300 ft., From 0 ft. to 0 ft.
 From 320 ft. to 400 ft., From 0 ft. to 0 ft.
 GRAVEL PACK INTERVALS: From 30 ft. to 405 ft., From 0 ft. to 0 ft.
 From 0 ft. to 0 ft., From 0 ft. to 0 ft.

6 GROUT MATERIAL BENTONITE
 Grout Intervals: From 0 ft. to 30 ft., From 0 ft. to 0 ft., From 0 ft. to 0 ft.
 What is the nearest source of possible contamination: ABANDONED WELL
 Direction from well? WEST How many feet? 15

FROM	TO	LITHOLOGIC LOG	FROM	TO	PLUGGING INTERVALS
0	20	01 TOPSOIL 32 TAN CLAY			
20	40	32 TAN CLAY 02 FINE SAND 19 LAYERS			
40	60	32 TAN CLAY 10 FINE-MEDSAND 19 LAYERS			
60	100	32 TAN CLAY			
100	120	32 TAN CLAY 35 CALACHIE			
120	140	35 CALACHIE 32 TAN CLAY 10 FINE-MEDSAND			
140	160	10 FINE-MEDSAND 17 CLAY LAYERS			
160	180	10 FINE-MEDSAND 05 CLAY			
180	200	05 CLAY 02 FINE SAND			
200	300	10 FINE-MEDSAND			

7 CONTRACTOR'S OR LANDOWNER'S CERTIFICATION: This water well was Constructed under my jurisdiction and was completed on (mo/day/year) 08/12/08 and this record is true to the best of my knowledge and belief. Kansas Water Well Contractor's License No. 179 This Water Well Record was completed on (mo/day/yr) 09/11/08 under the business name of JOE'S WELL SERVICE, INC. by (signature) *Judith Creek*

(Continued)

WATER WELL RECORD Form WWC-5 KSA 82a-1212

1 LOCATION OF WATER WELL:	Fraction	Section Number	Township Number	Range Number
COUNTY: STEVENS	SE 1/4 SE 1/4 SE 1/4	9	T 31 S	R 36 W

2 WATER WELL OWNER:	OWENS, MIKE	Board of Agriculture, Division of Water Resources
RR#, St. Address, Box # :	RR #1 -- BOX 14	Application Number:
City, State, ZIP code :	MOSCOW, KS 67952-	

FROM	TO	LITHOLOGIC LOG
300	320	32 TAN CLAY 05 CLAY
320	380	32 TAN CLAY 05 CLAY 10 FINE-MEDSAND
380	400	10 FINE-MEDSAND 32 TAN CLAY
400	420	05 CLAY

7 CONTRACTOR'S OR LANDOWNER'S CERTIFICATION: This water well was Constructed under my jurisdiction and was completed on (mo/day/year) 08/12/08 and this record is true to the best of my knowledge and belief. Kansas Water Well Contractor's License No. 179 This Water Well Record was completed on (mo/day/yr) 09/11/08 under the business name of JOE'S WELL SERVICE, INC. by (signature) *Justin Clark*