

WATER WELL RECORD

Form WWC-5

1362240

Division of Water
Resources App. No.

[]


Well ID

[]

- Original Record
- Correction
- Change in Well Use

1 LOCATION OF WATER WELL: County:	Fraction 1/4 1/4 1/4 1/4	Section Number	Township Number T S	Range Number R E W
---	-----------------------------------	----------------	--------------------------	---------------------------

2 WELL OWNER: Last Name: Business: Address: Address: City: State: ZIP:	First:	Street or Rural Address where well is located (if unknown, distance and direction from nearest town or intersection): If at owner’s address, check here: <input type="checkbox"/>
---	--------	---

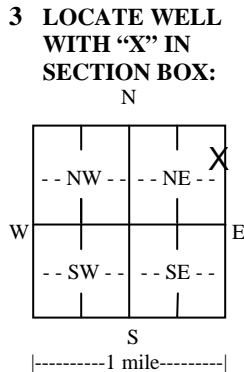

4 DEPTH OF COMPLETED WELL: ft.
 Depth(s) Groundwater Encountered: 1) ft.
 2) ft. 3) ft., or 4) Dry Well

WELL’S STATIC WATER LEVEL: ft.
 below land surface, measured on (mo-day-yr).....
 above land surface, measured on (mo-day-yr).....

Pump test data: Well water was ft.
 after..... hours pumping gpm
 Well water was ft.
 after..... hours pumping gpm

Estimated Yield:gpm
Bore Hole Diameter: in. to ft. and
 in. to ft.

5 Latitude:(decimal degrees)
Longitude:(decimal degrees)
 Datum: WGS 84 NAD 83 NAD 27
Source for Latitude/Longitude:
 GPS (unit make/model:)
 (WAAS enabled? Yes No)
 Land Survey Topographic Map
 Online Mapper:

6 Elevation:ft. Ground Level TOC
Source: Land Survey GPS Topographic Map
 Other

7 WELL WATER TO BE USED AS:

1. Domestic: <input type="checkbox"/> Household <input type="checkbox"/> Lawn & Garden <input type="checkbox"/> Livestock 2. <input type="checkbox"/> Irrigation 3. <input type="checkbox"/> Feedlot 4. <input type="checkbox"/> Industrial	5. <input type="checkbox"/> Public Water Supply: well ID 6. <input type="checkbox"/> Dewatering: how many wells? 7. <input type="checkbox"/> Aquifer Recharge: well ID 8. <input type="checkbox"/> Monitoring: well ID 9. Environmental Remediation: well ID <input type="checkbox"/> Air Sparge <input type="checkbox"/> Soil Vapor Extraction <input type="checkbox"/> Recovery <input type="checkbox"/> Injection	10. <input type="checkbox"/> Oil Field Water Supply: lease 11. Test Hole: well ID <input type="checkbox"/> Cased <input type="checkbox"/> Uncased <input type="checkbox"/> Geotechnical 12. Geothermal: how many bores? a) Closed Loop <input type="checkbox"/> Horizontal <input type="checkbox"/> Vertical b) Open Loop <input type="checkbox"/> Surface Discharge <input type="checkbox"/> Inj. of Water 13. <input type="checkbox"/> Other (specify):
---	--	---

Was a chemical/bacteriological sample submitted to KDHE? Yes No If yes, date sample was submitted:

Water well disinfected? Yes No

8 TYPE OF CASING USED: Steel PVC Other **CASING JOINTS:** Glued Clamped Welded Threaded
 Casing diameter in. to ft., Diameter in. to ft., Diameter in. to ft.
 Casing height above land surface in. Weight lbs./ft. Wall thickness or gauge No.

TYPE OF SCREEN OR PERFORATION MATERIAL:
 Steel Stainless Steel Fiberglass PVC Other (Specify)
 Brass Galvanized Steel Concrete tile None used (open hole)

SCREEN OR PERFORATION OPENINGS ARE:
 Continuous Slot Mill Slot Gauze Wrapped Torch Cut Drilled Holes Other (Specify)
 Louvered Shutter Key Punched Wire Wrapped Saw Cut None (Open Hole)

SCREEN-PERFORATED INTERVALS: From ft. to ft., From ft. to ft., From ft. to ft.

GRAVEL PACK INTERVALS: From ft. to ft., From ft. to ft., From ft. to ft.

9 GROUT MATERIAL: Neat cement Cement grout Bentonite Other
 Grout Intervals: From ft. to ft., From ft. to ft., From ft. to ft.

Nearest source of possible contamination:
 Septic Tank Lateral Lines Pit Privy Livestock Pens Insecticide Storage
 Sewer Lines Cess Pool Sewage Lagoon Fuel Storage Abandoned Water Well
 Watertight Sewer Lines Seepage Pit Feedyard Fertilizer Storage Oil Well/Gas Well
 Other (Specify)

Direction from well? Distance from well? ft.

10 FROM	TO	LITHOLOGIC LOG	FROM	TO	LITHO. LOG (cont.) or PLUGGING INTERVALS

Notes:

11 CONTRACTOR’S OR LANDOWNER’S CERTIFICATION: This water well was constructed, reconstructed, or plugged under my jurisdiction and was completed on (mo-day-year) and this record is true to the best of my knowledge and belief. Kansas Water Well Contractor’s License No. This Water Well Record was completed on (mo-day-year) under the business name of

Form	WWC5
Contractor	Downey Drilling, Inc.
Well Owner	TOM LAHEY
Doc ID	1362240

Litholgy

From	To	LithologicLog
0	2	TOP SOIL / SILT
2	60	SANDY CLAY W/ TR MAG
60	111	CLAY / SANDY CLAY
111	122	CLAY
122	128	CLAY W/ M/C SAND
128	140	M/C SAND & CLAY W/ MAG
140	154	CLAY & MAG
154	159	CLAY W/ F. GRAVEL
159	183	C/VC SAND & F. GRAVEL
183	195	F/M SAND & TR C W/ SILT
195	195.5	MAG
195.5	204	CLAY
204	280	M/C SAND & F. GRAVEL
280	288	C/VC SAND & F. GRAVEL
288	297	M/C SAND
297	313	C/VC SAND & TR. F. GRAVEL
313	318.5	CEM. SAND
318.5	334	CLAY
334	342	MED SAND
342	354	CLAY
354	363	C/VVC SAND & F. GRAVEL
363	369	SILT AND CLAY

Form	WWC5
Contractor	Downey Drilling, Inc.
Well Owner	TOM LAHEY
Doc ID	1362240

Litholgy

From	To	LithologicLog
369	387	C/VVC SAND & TR. F. GRAVEL
387	393	SILTSTONE
393	405	M/C SAND
405	410	SILTSTONE
410	420	F/M SAND
420	440	F/M SAND
440	460	F. SAND & BROWN ROCK
460	500	F. SAND/TR SS & ROCK
500	520	F. SAND / SS & ROCK
520	529	F. SAND & SS ROCK
529	540	SILTSTONE/SS