


1 LOCATION OF WATER WELL: County: STEVENS	Fraction SW 1/4 NW 1/4 NW 1/4	Section Number 5	Township Number T 31 S	Range Number R 36 EW
---	---	----------------------------	----------------------------------	--------------------------------

Distance and direction from nearest town or city street address of well if located within city? **From Moscow, KS go 4 1/2 Miles North, 3 Miles West, 3/8 Mile South, East into location.**

2 WATER WELL OWNER: **Jack Shriver** Mobil Oil Corporation
 RR#, St. Address, Box # : Board of Agriculture, Division of Water Resources
 City, State, ZIP Code : **Coats, Kansas 67028** Application Number: **T87-95**

3 LOCATE WELL'S LOCATION WITH AN "X" IN SECTION BOX:

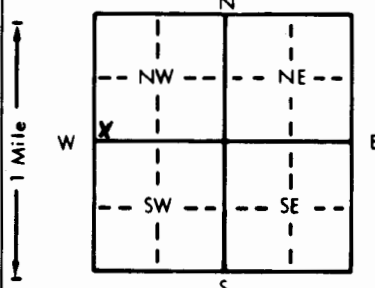

4 DEPTH OF COMPLETED WELL: **480** ft. ELEVATION: _____
 Depth(s) Groundwater Encountered 1. **340** ft. 2. _____ ft. 3. _____ ft.
 WELL'S STATIC WATER LEVEL **140** ft. below land surface measured on mo/day/yr **3-13-87**
 Pump test data: Well water was _____ ft. after _____ hours pumping _____ gpm
 Est. Yield **100** gpm: Well water was _____ ft. after _____ hours pumping _____ gpm
 Bore Hole Diameter: **11** in. to **480** ft., and _____ in. to _____ ft.

WELL WATER TO BE USED AS:
 5 Public water supply 8 Air conditioning 11 Injection well
 1 Domestic 3 Feedlot **6 Oil field water supply** 9 Dewatering 12 Other (Specify below)
 2 Irrigation 4 Industrial 7 Lawn and garden only 10 Monitoring well
 Was a chemical/bacteriological sample submitted to Department? Yes _____ No **NO**; If yes, mo/day/yr sample was submitted
 Water Well Disinfected? Yes **XX** No

5 TYPE OF BLANK CASING USED:
 1 Steel 3 RMP (SR) 5 Wrought iron 8 Concrete tile CASING JOINTS: Glued _____ Clamped _____
2 PVC 4 ABS 6 Asbestos-Cement 9 Other (specify below) Welded _____
 7 Fiberglass Threaded _____

Blank casing diameter **6 5/8** in. to **200** ft., Dia _____ in. to _____ ft., Dia _____ in. to _____ ft.
 Casing height above land surface **-60** in., weight **2.85** lbs./ft. Wall thickness or gauge No. _____

TYPE OF SCREEN OR PERFORATION MATERIAL:
 1 Steel 3 Stainless steel 5 Fiberglass **7 PVC** 10 Asbestos-cement
 2 Brass 4 Galvanized steel 6 Concrete tile 8 RMP (SR) 11 Other (specify) _____
 12 None used (open hole)

SCREEN OR PERFORATION OPENINGS ARE:
 1 Continuous slot 3 Mill slot 5 Gauzed wrapped **8 Saw cut** 11 None (open hole)
 2 Louvered shutter 4 Key punched 6 Wire wrapped 9 Drilled holes
 7 Torch cut 10 Other (specify) _____

SCREEN-PERFORATED INTERVALS: From **200** ft. to **480** ft., From _____ ft. to _____ ft.
 From _____ ft. to _____ ft., From _____ ft. to _____ ft.
 GRAVEL PACK INTERVALS: From **25** ft. to **190** ft., From **200** ft. to **480** ft.
 From _____ ft. to _____ ft., From _____ ft. to _____ ft.

6 GROUT MATERIAL: **1** Neat cement 2 Cement grout 3 Bentonite 4 Other _____
 Grout Intervals: From **XX** 0 ft. to **6** ft., From **6** ft. to **25** ft., From **190** ft. to **200** ft.

What is the nearest source of possible contamination:
 1 Septic tank 4 Lateral lines 7 Pit privy 10 Livestock pens 14 Abandoned water well
 2 Sewer lines 5 Cess pool 8 Sewage lagoon 11 Fuel storage **15 Oil well/Gas well**
 3 Watertight sewer lines 6 Seepage pit 9 Feedyard 12 Fertilizer storage 16 Other (specify below)
 13 Insecticide storage
 Direction from well? **southeast of water well** How many feet? **160**

FROM	TO	LITHOLOGIC LOG	FROM	TO	PLUGGING INTERVALS
			0	5	Backfill
			5	6	Neat Cement
			6	26	Bentonite Grout
			26	190	Chlorinated Gravel
			190	200	Bentonite Grout
			200	480	Chlorinated Gravel
					Glued cap on casing & backfilled Gravel packed, hole plugged and cemented casing, then dug out casing to -5'.

7 CONTRACTOR'S OR LANDOWNER'S CERTIFICATION: This water well was (1) constructed, (2) reconstructed, or **(3) plugged under my jurisdiction** and was completed on (mo/day/year) **9-20-89** and this record is true to the best of my knowledge and belief. Kansas Water Well Contractor's License No. **118** This Water Well Record was completed on (mo/day/yr) **9-22-89** under the business name of **Carlile Water Well Service, Inc.** by (signature) _____