


1 LOCATION OF WATER WELL: County: Stevens Near C 1/4 NW 1/4 NW 1/4 Section Number 25 Township Number T 31 S Range Number R 36 EW

Distance and direction from nearest town or city street address of well if located within city? Moscow, Kansas - northeast corner 1/2 mi east south into. (Hwy 56 goes northeast)

2 WATER WELL OWNER: Mike Gaskill Mobil Oil Corp./ Unit #19 RR#, St. Address, Box #: Board of Agriculture, Division of Water Resources City, State, ZIP Code: Moscow, Kansas 67952 Application Number: T89-134

3 LOCATE WELL'S LOCATION WITH AN "X" IN SECTION BOX:

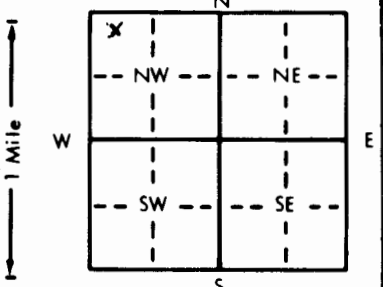

4 DEPTH OF COMPLETED WELL: 400 ft. ELEVATION: WELL'S STATIC WATER LEVEL 20.7 ft. below land surface measured on mo/day/yr 3-25-89

Depth(s) Groundwater Encountered 1. 20.7 ft. 2. ft. 3. ft. Pump test data: Well water was ft. after hours pumping gpm Est. Yield 100 gpm: Well water was ft. after hours pumping gpm Bore Hole Diameter 11 in. to 400 ft., and in. to ft. WELL WATER TO BE USED AS: 5 Public water supply 8 Air conditioning 11 Injection well 1 Domestic 3 Feedlot 6 Oil field water supply 9 Dewatering 12 Other (Specify below) 2 Irrigation 4 Industrial 7 Lawn and garden only 10 Monitoring well Was a chemical/bacteriological sample submitted to Department? Yes No X If yes, mo/day/yr sample was submitted Water Well Disinfected? Yes X No

5 TYPE OF BLANK CASING USED: 1 Steel 3 RMP (SR) 5 Wrought iron 8 Concrete tile CASING JOINTS: Glued X Clamped 2 PVC 4 ABS 6 Asbestos-Cement 9 Other (specify below) Welded 7 Fiberglass Threaded

Blank casing diameter 6 5/8 in. to 260 ft., Dia. in. to ft., Dia. in. to ft. Casing height above land surface 30 in., weight 3.71 lbs./ft. Wall thickness or gauge No. 280

TYPE OF SCREEN OR PERFORATION MATERIAL: 1 Steel 3 Stainless steel 5 Fiberglass 8 RMP (SR) 10 Asbestos-cement 2 Brass 4 Galvanized steel 6 Concrete tile 9 ABS 11 Other (specify) 12 None used (open hole)

SCREEN OR PERFORATION OPENINGS ARE: 1 Continuous slot 3 Mill slot 5 Gauzed wrapped 8 Saw cut 11 None (open hole) 2 Louvered shutter 4 Key punched 6 Wire wrapped 9 Drilled holes 7 Torch cut 10 Other (specify)

SCREEN-PERFORATED INTERVALS: From 260 ft. to 400 ft., From 150 ft. to 400 ft. GRAVEL PACK INTERVALS: From 22 ft. to 140 ft., From 150 ft. to 400 ft.

6 GROUT MATERIAL: 1 Neat cement 2 Cement grout 3 Bentonite 4 Other Grout Intervals: From 0 ft. to 2 ft., From 2 ft. to 22 ft., From 140 ft. to 150 ft.

What is the nearest source of possible contamination: 1 Septic tank 4 Lateral lines 7 Pit privy 10 Livestock pens 14 Abandoned water well 2 Sewer lines 5 Cess pool 8 Sewage lagoon 11 Fuel storage 15 Oil well/Gas well 3 Watertight sewer lines 6 Seepage pit 9 Feedyard 12 Fertilizer storage 16 Other (specify below) 13 Insecticide storage Direction from well? Southwest How many feet? 180'

Table with columns: FROM, TO, LITHOLOGIC LOG, FROM, TO, PLUGGING INTERVALS. Rows describe geological layers from surface to 400 ft depth.

7 CONTRACTOR'S OR LANDOWNER'S CERTIFICATION: This water well was (1) constructed, (2) reconstructed, or (3) plugged under my jurisdiction and was completed on (mo/day/year) 3-25-89 and this record is true to the best of my knowledge and belief. Kansas Water Well Contractor's License No. 118 This Water Well Record was completed on (mo/day/yr) 3-27-89 under the business name of Carlile Water Well Service, Inc. by (signature)