


USE TYPEWRITER OR BALL POINT PEN-PRESS FIRMLY, PRINT CLEARLY.

WATER WELL RECORD
KSA 82a-1201-1215

Kansas Department of Health and Environment-Division of Environment (Water well Contractors) Topeka, Kansas 66620

1. Location of well: County Stevens Fraction NW 1/4 NW 1/4 NE 1/4 Section number 33 Township number T 31 S Range number R 36 E/W

2. Distance and direction from nearest town or city: Street address of well location if in city: 1/2 W of Moscow, KS
3. Owner of well: John Reimer
R.R. or street: R. R.
City, state, zip code: Plains Kansas 67869

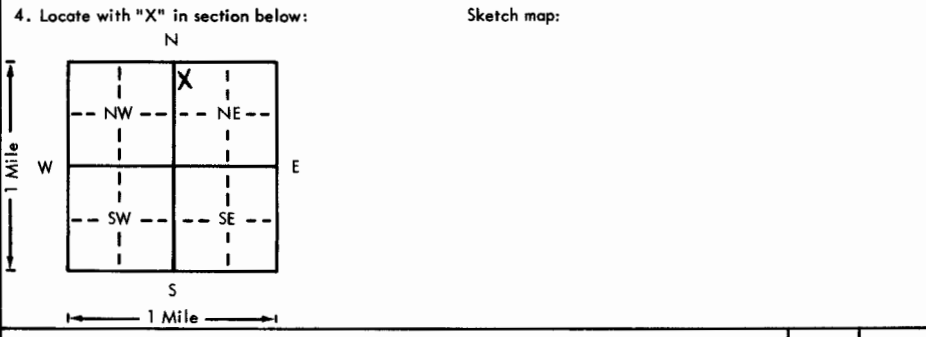

6. Bore hole dia. 10 in. Completion date 2-11-77
Well depth 360 ft.
7. Cable tool Rotary Driven Dug
 Hollow rod Jetted Bored Reverse rotary
8. Use: Domestic Public supply Industry
 Irrigation Air conditioning Stock
 Lawn Oil field water Other
9. Casing: Material _____ Height: Above or below
Threaded Welded _____ Surface 12 in.
RMP _____ PVC Weight _____ lbs./ft.
Dia. 5 in. to 360 ft. depth Wall Thickness: inches or
Dia. _____ in. to _____ ft. depth gage No. 250

5. Type and color of material	From	To
dark loam	6	25
tan silts sandy limy	25	37
Clay balls small	37	68
sand - brown - fine	68	72
Clay " w/ some sand	72	97
Sand	97	108
Clay balls tan sticky	108	128
caliche white & buff - limy	128	157
Gravel coarse sand	157	164
" & sand hard	164	178
Sand coarse w/ clays	178	198
Clay & sand fine sand	198	240
Clay & sand silty	240	317
Sand coarse & fine gravel	317	360

10. Screen: Manufacturer's name Slocum
Type Saw Cut Dia. 5"
Slot/gauze 1/8" Length 40'
Set between 180 ft. and 200 ft.
340 ft. and 360 ft.
Gravel pack? Size range of material _____
11. Static water level: _____ mo./day/yr.
175 ft. below land surface Date 2-11-77
12. Pumping level below land surfaces:
180 ft. after 4 hrs. pumping 14 g.p.m.
_____ ft. after _____ hrs. pumping _____ g.p.m.
Estimated maximum yield _____ g.p.m.
13. Water sample submitted: _____ mo./day/yr.
Yes No Date _____
14. Well head completion:
 Pitless adapter 12 inches above grade
15. Well grouted?
With: Neat cement Bentonite Concrete
Depth: From 3 ft. to 13 ft.
16. Nearest source of possible contamination:
ft. 100 Direction W Type septic
Well disinfected upon completion? Yes No
17. Pump: _____ Not installed
Manufacturer's name Flint + Walling
Model number _____ HP 1 1/2 Volts 230
Length of drop pipe 240 ft. capacity 13 g.p.m.
Type:
 Submersible Turbine
 Jet Reciprocating
 Centrifugal Other

18. Elevation: Topography: _____ Hill _____ Slope _____ Upland _____ Valley
19. Remarks:
20. Water well contractor's certification:
This well was drilled under my jurisdiction and this report is true to the best of my knowledge and belief.
Slocum Well Drilling 127
Business name _____ License No. _____
Address Hugoton Kansas
Signed Paul Slocum Date 2-16
Authorized representative

31
36
33
NW 1/4 NE 1/4