


1 LOCATION OF WATER WELL: County: STEVENS Fraction: SE 1/4 SW 1/4 NE 1/4 Section Number: 33 Township Number: T 31 S Range Number: R 36

Distance and direction from nearest town or city street address of well if located within city?
 254' SOUTH AND 154' WEST OF THE OLD WELL.

2 WATER WELL OWNER: CHARLES DUDLEY ESTATE
 RR#, St. Address, Box # : P.O. BOX 2908 Board of Agriculture, Division of Water Resources
 City, State, ZIP Code : FRISCO, CO 80443 Application Number: 4082

3 LOCATE WELL'S LOCATION WITH AN "X" IN SECTION BOX:

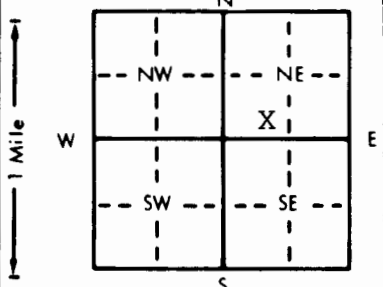

4 DEPTH OF COMPLETED WELL: 577 ft. ELEVATION:

Depth(s) Groundwater Encountered 1. ft. 2. ft. 3. ft.
 WELL'S STATIC WATER LEVEL . 2.35 ft. below land surface measured on mo/day/yr . 3/19/93
 Pump test data: Well water was ft. after hours pumping gpm
 Est. Yield gpm: Well water was ft. after hours pumping gpm
 Bore Hole Diameter . . 26 in. to . . 577 ft., and in. to ft.
 WELL WATER TO BE USED AS: 5 Public water supply 8 Air conditioning 11 Injection well
 1 Domestic 3 Feedlot 6 Oil field water supply 9 Dewatering 12 Other (Specify below)
 Irrigation 4 Industrial 7 Lawn and garden only 10 Monitoring well
 Was a chemical/bacteriological sample submitted to Department? Yes No If yes, mo/day/yr sample was submitted
 Water Well Disinfected? Yes No

5 TYPE OF BLANK CASING USED: 1 Steel 3 RMP (SR) 5 Wrought iron 8 Concrete tile CASING JOINTS: Glued Clamped
 2 PVC 4 ABS 6 Asbestos-Cement 9 Other (specify below) Welded X
 7 Fiberglass Threaded

Blank casing diameter . . 16 in. to . . 577 ft., Dia in. to ft., Dia in. to ft.
 Casing height above land surface . . 12 in., weight . . 42.5 lbs./ft. Wall thickness or gauge No. . . 250

TYPE OF SCREEN OR PERFORATION MATERIAL: 1 Steel 3 Stainless steel 5 Fiberglass 7 PVC 10 Asbestos-cement
 2 Brass 4 Galvanized steel 6 Concrete tile 8 RMP (SR) 11 Other (specify)
 9 ABS 12 None used (open hole)

SCREEN OR PERFORATION OPENINGS ARE: 1 Continuous slot 2 Louvered shutter 3 Mill slot 4 Key punched 5 Gauzed wrapped 6 Wire wrapped 7 Torch cut 8 Saw cut 11 None (open hole)
 9 Drilled holes 10 Other (specify)

SCREEN-PERFORATED INTERVALS: From SCREEN 350 ft. to . . 430 ft., From PERF. 430 ft. to . . 535 ft.
 From SCREEN 535 ft. to . . 575 ft., From ft. to ft.
 GRAVEL PACK INTERVALS: From . . 20 ft. to . . 577 ft., From ft. to ft.
 From ft. to ft., From ft. to ft.

6 GROUT MATERIAL: 1 Neat cement 2 Cement grout 3 Bentonite 4 Other

Grout intervals: From . . 0 ft. to . . 20 ft., From ft. to ft., From ft. to ft.
 What is the nearest source of possible contamination: 1 Septic tank 4 Lateral lines 7 Pit privy 10 Livestock pens 14 Abandoned water well
 2 Sewer lines 5 Cess pool 8 Sewage lagoon 11 Fuel storage 15 Oil well/Gas well
 3 Watertight sewer lines 6 Seepage pit 9 Feedyard 12 Fertilizer storage 13 Insecticide storage 16 Other (specify below)
 CROPLAND - NOTHING
 IMMEDIATE VICINITY

Direction from well? How many feet?

FROM	TO	LITHOLOGIC LOG	FROM	TO	PLUGGING INTERVALS
0	280	SURFACE			
280	440	MED. TO COARSE SAND			
440	452	FINE SAND			
452	532	SANDY BROWN CLAY			
532	554	MED. COARSE SAND			
554	574	SANDY BROWN CLAY			
574	580	RED & BROWN CLAY			

7 CONTRACTOR'S OR LANDOWNER'S CERTIFICATION: This water well was constructed, (2) reconstructed, or (3) plugged under my jurisdiction and was completed on (mo/day/year) . . . 3/17/93 and this record is true to the best of my knowledge and belief. Kansas Water Well Contractor's License No. . . . 225 This Water Well Record was completed on (mo/day/yr) . . . 3/23/93 under the business name of KTM DRILLING, INC. by (signature) *Gradd Winter*