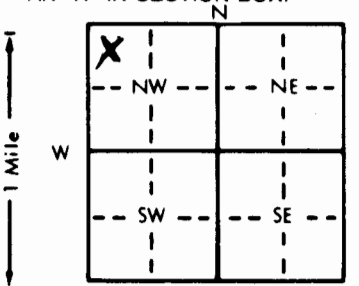


1 LOCATION OF WATER WELL: County: **STEVENS** Fraction **NW 1/4 NW 1/4 NW 1/4** Section Number **23** Township Number **T 31 S** Range Number **R 36W EW**

Distance and direction from nearest town or city street address of well if located within city?
WEST SIDE OF MOSCOW NORTH 1/2 TO 3/4 MILES INTO A NEW HOUSE EAST SIDE OF.

2 WATER WELL OWNER: **TOM DORSEY**
 RR#, St. Address, Box # :
 City, State, ZIP Code : **MOSCOW, KS 67952**
 Board of Agriculture, Division of Water Resources
 Application Number:

3 LOCATE WELL'S LOCATION WITH AN "X" IN SECTION BOX:

 4 DEPTH OF COMPLETED WELL: **480** ft. ELEVATION:
 Depth(s) Groundwater Encountered 1. **190** ft. 2. ft. 3. ft.
 WELL'S STATIC WATER LEVEL **190** ft. below land surface measured on **mo/day/yr 3-25-95**
 Pump test data: Well water was **210** ft. after **1** hours pumping **70** gpm
 Est. Yield **70** gpm: Well water was ft. after hours pumping gpm
 Bore Hole Diameter **9 1/2** in. to **480** ft., and in. to ft.
 WELL WATER TO BE USED AS:
 1 Domestic 2 Irrigation 3 Feedlot 4 Industrial 5 Public water supply 6 Oil field water supply 7 Lawn and garden only 8 Air conditioning 9 Dewatering 10 Monitoring well 11 Injection well 12 Other (Specify below)
 Was a chemical/bacteriological sample submitted to Department? Yes.....No If yes, mo/day/yr sample was submitted
 Water Well Disinfected? Yes No

5 TYPE OF BLANK CASING USED:
 1 Steel 2 PVC 3 RMP (SR) 4 ABS 5 Wrought iron 6 Asbestos-Cement 7 Fiberglass 8 Concrete tile 9 Other (specify below)
 Blank casing diameter **5** in. to **480** ft., Dia in. to ft., Dia in. to ft.
 Casing height above land surface **24** in., weight **2.902** lbs./ft. Wall thickness or gauge No. **.280 SDR 21**
 TYPE OF SCREEN OR PERFORATION MATERIAL:
 1 Steel 2 Brass 3 Stainless steel 4 Galvanized steel 5 Fiberglass 6 Concrete tile 7 PVC 8 RMP (SR) 9 ABS 10 Asbestos-cement 11 Other (specify) 12 None used (open hole)
 SCREEN OR PERFORATION OPENINGS ARE:
 1 Continuous slot 2 Louvered shutter 3 Mill slot 4 Key punched 5 Gauzed wrapped 6 Wire wrapped 7 Torch cut 8 Saw cut 9 Drilled holes 10 Other (specify) 11 None (open hole)
 SCREEN-PERFORATED INTERVALS: From **315** ft. to **480** ft., From ft. to ft., From ft. to ft.
 GRAVEL PACK INTERVALS: From **300** ft. to **480** ft., From ft. to ft., From ft. to ft.

6 GROUT MATERIAL: 1 Neat cement 2 Cement grout 3 Bentonite 4 Other **HOLE PLUG**
 Grout Intervals: From **1** ft. to **20** ft., From ft. to ft., From ft. to ft.
 What is the nearest source of possible contamination:
 1 Septic tank 2 Sewer lines 3 Watertight sewer lines 4 Lateral lines 5 Cess pool 6 Seepage pit 7 Pit privy 8 Sewage lagoon 9 Feedyard 10 Livestock pens 11 Fuel storage 12 Fertilizer storage 13 Insecticide storage 14 Abandoned water well 15 Oil well/Gas well 16 Other (specify below)
 Direction from well? How many feet?

FROM	TO	LITHOLOGIC LOG	FROM	TO	PLUGGING INTERVALS
0	2	CLAY	249	270	SANDY CLAY & CLAY
2	32	CALICHE CLAY	270	278	SAND
32	52	CLAY	278	300	SANDY CLAY
52	64	SAND	300	305	CLAY
64	115	CLAY	305	330	SAND
115	141	CLAY & SANDY CLAY	330	345	CLAY
141	160	SANDY CLAY	345	370	SANDY CLAY
160	171	SAND	370	380	CLAY
171	180	SANDY CLAY	380	397	SANDY CLAY
180	210	SAND & CLAY	397	412	SAND & SANDY CLAY
210	220	CLAY	412	420	CLAY
220	230	SAND	420	443	SANDY CLAY & CLAY
230	237	CLAY	443	475	SAND STONE
237	246	SAND	475	480	RED SANDY CLAY
246	249	CLAY			

7 CONTRACTOR'S OR LANDOWNER'S CERTIFICATION: This water well was (1) constructed, (2) reconstructed, or (3) plugged under my jurisdiction and was completed on (mo/day/year) **3-25-95** and this record is true to the best of my knowledge and belief. Kansas Water Well Contractor's License No. **KWCL-430** This Water Well Record was completed on (mo/day/yr) **3-25-95** under the business name of **HOWARD DRUG CO. BOX 806 BEAVER, OK 73932** by (signature) *[Signature]*

OFFICE USE ONLY