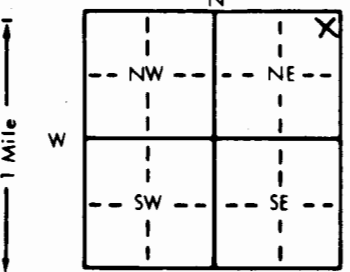


1 LOCATION OF WATER WELL: County: STEVENS	Fraction NE 1/4 NE 1/4 NE 1/4	Section Number 4	Township Number T 31 S	Range Number R 37W E/W
---	---	----------------------------	----------------------------------	----------------------------------

Distance and direction from nearest town or city street address of well if located within city?

FROM HUGOTON NORTH ON HWY 25 13 MILES, TO STEVENS GRANT CO LINE.

2 WATER WELL OWNER: ANADARKO RR#, St. Address, Box # : 3814 N. SANTA FE City, State, ZIP Code : OKLAHOMA CITY, OK 73118	Board of Agriculture, Division of Water Resources Application Number:
--	--

3 LOCATE WELL'S LOCATION WITH AN "X" IN SECTION BOX: 	4 DEPTH OF COMPLETED WELL: 320 ft. ELEVATION: Depth(s) Groundwater Encountered 1. 210 ft. 2. ft. 3. ft. WELL'S STATIC WATER LEVEL 210 ft. below land surface measured on mo/day/yr 07-21-95 Pump test data: Well water was 230 ft. after 1 hours pumping 95 gpm Est. Yield 95 gpm: Well water was ft. after hours pumping gpm Bore Hole Diameter 9 1/2 in. to 320 ft. and in. to ft. WELL WATER TO BE USED AS: <input checked="" type="radio"/> 1 Domestic 3 Feedlot 6 Oil field water supply 9 Dewatering 12 Other (Specify below) <input type="radio"/> 2 Irrigation 4 Industrial 7 Lawn and garden only 10 Monitoring well Was a chemical/bacteriological sample submitted to Department? Yes.....No X; If yes, mo/day/yr sample was submitted Water Well Disinfected? Yes X No
--	--

5 TYPE OF BLANK CASING USED: 1 Steel 3 RMP (SR) <input checked="" type="radio"/> 2 PVC 4 ABS Blank casing diameter 5 in. to 320 ft., Dia in. to ft., Dia in. to ft. Casing height above land surface 24 in., weight 2.902 lbs./ft. Wall thickness or gauge No. .280 SDR 21 TYPE OF SCREEN OR PERFORATION MATERIAL: 1 Steel 3 Stainless steel 5 Fiberglass 7 PVC 10 Asbestos-cement 2 Brass 4 Galvanized steel 6 Concrete tile 8 RMP (SR) 11 Other (specify) 12 None used (open hole) SCREEN OR PERFORATION OPENINGS ARE: 1 Continuous slot 3 Mill slot 5 Gauzed wrapped <input checked="" type="radio"/> 8 Saw cut 11 None (open hole) 2 Louvered shutter 4 Key punched 6 Wire wrapped 9 Drilled holes 7 Torch cut 10 Other (specify) SCREEN-PERFORATED INTERVALS: From 280 ft. to 320 ft., From ft. to ft. GRAVEL PACK INTERVALS: From 260 ft. to 320 ft., From ft. to ft.
--

6 GROUT MATERIAL: <input checked="" type="radio"/> 1 Neat cement 2 Cement grout 3 Bentonite <input checked="" type="radio"/> 4 Other HOLE PLUG Grout Intervals: From 0 ft. to 16 ft., From ft. to ft., From ft. to ft. What is the nearest source of possible contamination: 1 Septic tank 4 Lateral lines 7 Pit privy 10 Livestock pens 14 Abandoned water well 2 Sewer lines 5 Cess pool 8 Sewage lagoon 11 Fuel storage 15 Oil well/Gas well 3 Watertight sewer lines 6 Seepage pit 9 Feedyard 12 Fertilizer storage 16 Other (specify below) 13 Insecticide storage Direction from well? How many feet?

FROM	TO	LITHOLOGIC LOG	FROM	TO	PLUGGING INTERVALS
0	2	CLAY	222	262	SAND
2	70	CLAY	262	280	SMALL GRAVEL
70	78	MED. GRAVEL	280	300	SAND
78	90	SAND & GRAVEL	300	320	COARSE SAND & SMALL GRAVEL
90	100	CLAY			
100	104	SANDY CLAY			
104	116	SAND			
116	118	ROCK			
118	128	COARSE SAND			
128	143	COARSE SAND W/CLAY STREAKS			
143	160	CALICHE CLAY			
160	185	CLAY & SANDY CLAY			
185	205	SAND			
205	218	SMALL & MED. GRAVEL W/CLAY STREAKS			
218	222	CLAY			

7 CONTRACTOR'S OR LANDOWNER'S CERTIFICATION: This water well was <input checked="" type="radio"/> (1) constructed, (2) reconstructed, or (3) plugged under my jurisdiction and was completed on (mo/day/year) 07-21-95 and this record is true to the best of my knowledge and belief. Kansas Water Well Contractor's License No. KWWCL-430 This Water Well Record was completed on (mo/day/yr) 07-21-95 under the business name of HOWARD DRUG CO. BOX 806 BEAVER, OK 73932 by (signature) <i>Howard Drug Co.</i>
--

INSTRUCTIONS: Use typewriter or ball point pen. PLEASE PRESS FIRMLY and PRINT clearly. Please fill in blanks, underline or circle the correct answers. Send top three copies to Kansas Department of Health and Environment, Bureau of Water, Topeka, Kansas 66620-0001. Telephone: 913-296-5545. Send one to WATER WELL OWNER and retain one for your records.

#21515