


1 LOCATION OF WATER WELL: Fraction Section Number Township Number Range Number
 COUNTY: 095 STEVENS NW 1/4 NW 1/4 NE 1/4 07 T 31 S R 37 W

Distance and direction from nearest town or city street address of well if located within city?
 FROM MOSCOW; APPX 9 MILES EAST & 3 MILES NORTH

2 WATER WELL OWNER: ROME FARM PARTNERSHIP
 RR#, St. Address, Box #: HCO 1 BOX 18 Board of Agriculture, Division of Water Resources
 City, State, ZIP code: HUGOTON, KS 67951-9014 Application Number: 17,722

3 LOCATE WELL'S LOCATION WITH AN "X" IN SECTION BOX:

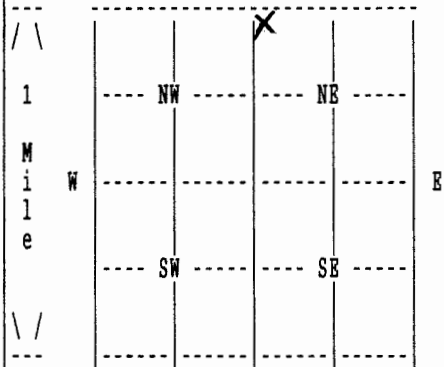

4 DEPTH OF COMPLETED WELL 492 ELEVATION: 0
 Depth(s) Groundwater Encountered 1. 0 ft. 2. 0 ft. 3. 0 ft.

WELL'S STATIC WATER LEVEL 273 ft. below land surface measured on mo/day/yr 04/19/06
 Pump test data: Well water was 300 ft. after 4 hours pumping 1400 gpm

Estimated Yield 0 gpm: Well water was 0 ft. after 0 hours pumping 0 gpm

Bore Hole Diameter 24 in. to 492 ft., and in. to 0 ft.

WELL WATER TO BE USED AS: 02 IRRIGATION

Was a chemical/bacteriological sample submitted to department? No ;
 If yes, mo/day/yr sample was submitted Water well disinfected? Yes

5 TYPE OF BLANK CASING USED: 01 STEEL CASING JOINTS: WELDED
 Blank casing diameter 16 in. to 492 ft., Dia in. to 0 ft., Dia in. to 0 ft.
 Casing height above land surface 12 in., weight 42 lbs/ft. Wall thickness or gauge No. .250
 TYPE OF SCREEN OR PERFORATION MATERIAL: 01 STEEL
 SCREEN OR PERFORATION OPENINGS ARE: 01 CONT. SLOT

SCREEN PERFORATED INTERVALS: From 307 ft. to 387 ft., From 0 ft. to 0 ft.
 From 387 ft. to 487 ft., From 0 ft. to 0 ft.
 GRAVEL PACK INTERVALS: From 20 ft. to 492 ft., From 0 ft. to 0 ft.
 From 0 ft. to 0 ft., From 0 ft. to 0 ft.

6 GROUT MATERIAL 03 BENTONITE
 Grout Intervals: From 0 ft. to 20 ft., From 0 ft. to 0 ft., From 0 ft. to 0 ft.
 What is the nearest source of possible contamination: NONE OBSERVED
 Direction from well? How many feet? 0

FROM	TO	LITHOLOGIC LOG	FROM	TO	PLUGGING INTERVALS
0	2	02 SILT			
2	89	04 SANDY CLAY 20 LIMESTONE 05 SAND			
89	143	05 SAND 01 CLAY			
143	156	04 SANDY CLAY 05 SAND			
156	249	05 SAND 28 ROCK			
249	250	04 SANDY CLAY			
250	257	07 FINE SAND			
257	290	05 SAND 28 ROCK			
290	297	04 SANDY CLAY			
297	300	05 SAND 28 ROCK			

7 CONTRACTOR'S OR LANDOWNER'S CERTIFICATION: This water well was Constructed under my jurisdiction and was completed on (mo/day/year) 04/14/06 and this record is true to the best of my knowledge and belief. Kansas Water Well Contractor's License No. 145 This Water Well Record was completed on (mo/day/yr) 06/23/06 under the business name of HENKLE DRILLING & SUPPLY by (signature)

(Continued)

WATER WELL RECORD Form WWC-5 KSA 82a-1212

1 LOCATION OF WATER WELL: COUNTY: 095 STEVENS	Fraction NW 1/4 NW 1/4 NE 1/4	Section Number 07	Township Number T 31 S	Range Number R 37 W
--	----------------------------------	----------------------	---------------------------	------------------------

2 WATER WELL OWNER: ROME FARM PARTNERSHIP
RR#, St. Address, Box # : HCO 1 BOX 18
City, State, ZIP code : HUGOTON, KS 67951-9014

Board of Agriculture, Division of Water Resources
Application Number: 17,722

FROM	TO	LITHOLOGIC LOG
300	308	03 SILTY CLAY
308	340	05 SAND 28 ROCK
340	365	07 FINE SAND 08 MEDIUM SAND
365	375	05 SAND 28 ROCK
375	410	05 SAND 01 CLAY
410	487	23 SANDSTONE
487	500	19 SHALE

7 CONTRACTOR'S OR LANDOWNER'S CERTIFICATION: This water well was Constructed under my jurisdiction and was completed on (mo/day/year) 04/14/06 and this record is true to the best of my knowledge and belief. Kansas Water Well Contractor's License No. 145 This Water Well Record was completed on (mo/day/yr) 06/23/06 under the business name of HENKLE DRILLING & SUPPLY by (signature) *Bruce J. Reichert*