


1 LOCATION OF WATER WELL: Fraction Section Number Township Number Range Number
 COUNTY: 095 STEVENS SE 1/4 SW 1/4 08 T 31 S R 37 W

Distance and direction from nearest town or city street address of well if located within city?
 FROM MOSCOW; APPX 8 3/4 MILES WEST & 2 1/2 MILES NORTH

2 WATER WELL OWNER: ROME FARMS Board of Agriculture, Division of Water Resources
 RR#, St. Address, Box #: HCO1 BOX 18 Application Number: 135
 City, State, ZIP code: HUGOTON, KS 67951-9014

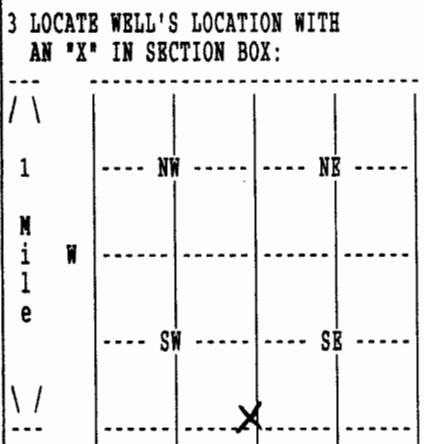

4 DEPTH OF COMPLETED WELL 533 ELEVATION: 0
 Depth(s) Groundwater Encountered 1. 0 ft. 2. 0 ft. 3. 0 ft.
 WELL'S STATIC WATER LEVEL 292 ft. below land surface measured on mo/day/yr 03/01/06
 Pump test data: Well water was 338 ft. after 4 hours pumping 1500 gpm
 Estimated Yield 0 gpm: Well water was 0 ft. after 0 hours pumping 0 gpm
 Bore Hole Diameter 24 in. to 533 ft., and in. to 0 ft.
 WELL WATER TO BE USED AS: 02 IRRIGATION
 Was a chemical/bacteriological sample submitted to department? No;
 If yes, mo/day/yr sample was submitted Water well disinfected? Yes

5 TYPE OF BLANK CASING USED: 01 STEEL CASING JOINTS: WELDED
 Blank casing diameter 16 in. to 533 ft., Dia in. to 0 ft., Dia in. to 0 ft.
 Casing height above land surface 12 in., weight 42 lbs/ft. Wall thickness or gauge No. .250
 TYPE OF SCREEN OR PERFORATION MATERIAL: 01 STEEL
 SCREEN OR PERFORATION OPENINGS ARE: 01 CONT. SLOT

SCREEN PERFORATED INTERVALS: From 338 ft. to 528 ft., From 0 ft. to 0 ft.
 From 0 ft. to 0 ft., From 0 ft. to 0 ft.
 GRAVEL PACK INTERVALS: From 20 ft. to 533 ft., From 0 ft. to 0 ft.
 From 0 ft. to 0 ft., From 0 ft. to 0 ft.

6 GROUT MATERIAL 03 BENTONITE
 Grout Intervals: From 0 ft. to 20 ft., From 0 ft. to 0 ft., From 0 ft. to 0 ft.
 What is the nearest source of possible contamination: 14 ABAND. WELL
 Direction from well? WEST How many feet? 2300

FROM	TO	LITHOLOGIC LOG	FROM	TO	PLUGGING INTERVALS
0	2	02 SILT			
2	109	04 SANDY CLAY 05 SAND 20 LIMESTONE			
109	119	05 SAND			
119	121	01 CLAY			
121	203	05 SAND 13 FINE GRAVEL			
203	209	04 SANDY CLAY			
209	331	05 SAND 13 FINE GRAVEL 14 MED GRAVEL			
331	339	05 SAND 01 CLAY			
339	350	05 SAND 28 ROCK			
350	358	05 SAND 01 CLAY			

7 CONTRACTOR'S OR LANDOWNER'S CERTIFICATION: This water well was Constructed under my jurisdiction and was completed on (mo/day/year) 02/24/06 and this record is true to the best of my knowledge and belief. Kansas Water Well Contractor's License No. 145 This Water Well Record was completed on (mo/day/yr) 04/19/06 under the business name of HENKLE DRILLING & SUPPLY by (signature)

1 LOCATION OF WATER WELL: COUNTY: 095 STEVENS	Fraction SW 1/4 SW 1/4 SE 1/4	Section Number 08	Township Number T 31 S	Range Number R 37 W
--	----------------------------------	----------------------	---------------------------	------------------------

2 WATER WELL OWNER: ROME FARMS
 RR#, St. Address, Box #: HCO1 BOX 18 Board of Agriculture, Division of Water Resources
 City, State, ZIP code : HUGOTON, KS 67951-9014 Application Number: 17,122

FROM	TO	LITHOLOGIC LOG
358	367	05 SAND 28 ROCK
367	375	05 SAND
375	437	05 SAND 28 ROCK
437	527	23 SANDSTONE 31 CALICHE
527	540	19 SHALE

7 CONTRACTOR'S OR LANDOWNER'S CERTIFICATION: This water well was Constructed under my jurisdiction and was completed on (mo/day/year) 02/24/06 and this record is true to the best of my knowledge and belief. Kansas Water Well Contractor's License No. 145 This Water Well Record was completed on (mo/day/yr) 04/19/06 under the business name of HENKLE DRILLING & SUPPLY by (signature) Bruce J. Reichmuth