

USE TYPEWRITER OR BALL POINT PEN-PRESS FIRMLY, PRINT CLEARLY.

T R EW sec 1/4 1/4 1/4 No.


WATER WELL RECORD
KSA 82a-1201-1215

Kansas State Dept. Of Health
(Water Well Contractors)
Forbes-Bldg. 740
Topeka, Kansas 66620

1 Location of well:	County Stevens	Township name	Fraction SE, SE, SE	Section number 15	Town number 31S	Range number 37W
---------------------	--------------------------	---------------	-------------------------------	-----------------------------	---------------------------	----------------------------

Distance and direction from nearest town or city: **5.5 miles W and 2 miles N of Moscow**
Street address of well location if in city:

3 Owner of well: **Carl Thurow**
Address: **Moscow, Kansas**

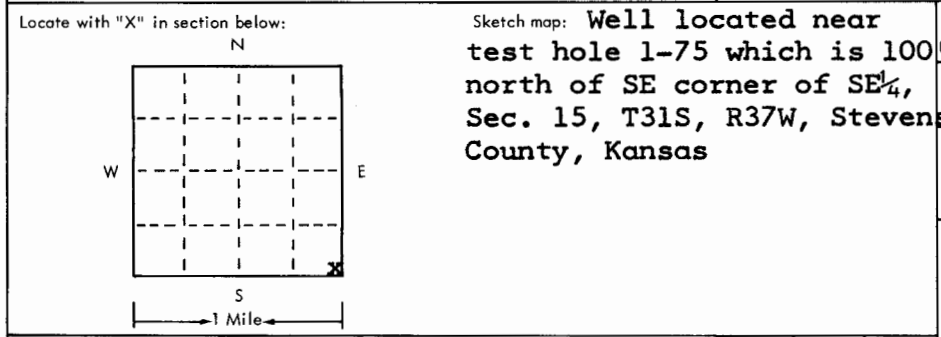

4 Well depth: **420** ft. Date of completion **8-25-75**
Well diameter **16** in.

5 Cable tool Rotary Driven Dug
 Hollow rod Jetted Bored Reverse rotary

6 Use: Domestic Public supply Industry
 Irrigation Air conditioning Commercial
 Test well

7 Casing: Material **Stl** Height: **above**/below
Threaded Welded Surface **12** in.
Diam. **16** in. Weight **37** lbs./ft. No
198 ft. depth Drive shoe? Yes No
16 in. to **198** ft. depth

2	Type and color of material	From	To
	Top soil	0	2
	Tan clay sand lenses	2	48
	Fine to medium sand	48	78
	Tan clay with fine to medium sand streaks	78	150
	Fine to coarse sand some clay lenses	150	180
	Tan clay very fine sand lenses	180	200
	Medium to coarse sand fine gravel, clay lens	200	238
	Tan clay	238	246
	Coarse sand fine to medium gravel	246	254
	Very fine to fine sand lots of clay lense	254	278
	Fine to coarse sand	278	292
	Tan clay	292	300
	Medium to coarse sand fine to med. gravel		
	firm but not tight	300	420
	Very fine to fine sand lense of clay very dirty	420	490
	Red Bed	490	500

8 Screen: **Foster & Brown**
Manufacturer **Millslot & Louver**
Type **16"** Dia. **16"**
Slot/gauze **1/8"** Length **222**
Set between **198** ft. and **420** ft.
Fittings: Yes No Size range of material **1.2mm & 9mm**
Gravel pack Yes No

9 Static water level: **160** ft. below land surface Date **8-25-75**

10 Pumping level below land surfaces **No test**
____ ft. after ____ hrs. pumping ____ g.p.m.
____ ft. after ____ hrs. pumping ____ g.p.m.
Estimated maximum yield ____ g.p.m.

11 Water sample submitted:
 Yes No Date _____

12 Well head completion:
 Pitless adapter **xx** inches above grade

13 Well grouted? Yes No
 Neat cement Bentonite _____
Depth: From **0** ft. to **10** ft.

14 Nearest source of possible contamination: **Unk**
ft. _____ Direction _____ Type _____
Well disinfected upon completion? Yes No

15 Pump: Not installed
Manufacturer's name _____
Model number _____ HP _____ Volts _____
Length of drop pipe _____ ft. capacity _____ g.m.p.
Type:
 Submersible Turbine
 Jet Reciprocating
 Centrifugal Other

16 Remarks: elevation

Topography:
 Hill
 Slope
 Upland
 Valley

17 Water well contractor's certification:
This well was drilled under my jurisdiction and this report is true to the best of my knowledge and belief.

Layne-Western Company, Inc. 150
Business name License No. _____
Address **P.O. Box 686, Garden City**
Signed **[Signature]** Date **22 Aug 75**
Authorized representative