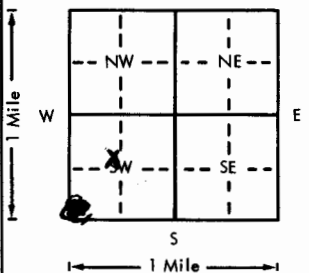


USE TYPEWRITER OR BALL POINT PEN-PRESS FIRMLY, PRINT CLEARLY.

WATER WELL RECORD  
KSA 82a-1201-1215

Kansas Department of Health and Environment-Division of Environment (Water well Contractors) Topeka, Kansas 66620

1. Location of well:	County <b>Stevens</b>	Fraction <b>SE 1/4 NW 1/4 SW 1/4</b>	Section number <b>24</b>	Township number <b>T 31 S</b>	Range number <b>R 37 E/W</b>
2. Distance and direction from nearest town or city: <b>18 miles south, 2 east of Ulysses, Ks.</b> Street address of well location if in city:			3. Owner of well: <b>Bill Hittle</b> R.R. or street: <b>Star Route</b> City, state, zip code: <b>Hugoton, Kansas 67901</b>		
4. Locate with "X" in section below: Sketch map: 			6. Bore hole dia. <b>27</b> in. Completion date _____ Well depth <b>490</b> ft. <b>7-8-76</b>		
5. Type and color of material <b>Surface</b>			7. <input checked="" type="checkbox"/> Cable tool <input checked="" type="checkbox"/> Rotary <input type="checkbox"/> Driven <input type="checkbox"/> Dug <input type="checkbox"/> Hollow rod <input type="checkbox"/> Jetted <input type="checkbox"/> Bored <input type="checkbox"/> Reverse rotary		
			8. Use: <input type="checkbox"/> Domestic <input type="checkbox"/> Public supply <input type="checkbox"/> Industry <input checked="" type="checkbox"/> Irrigation <input type="checkbox"/> Air conditioning <input type="checkbox"/> Stock <input type="checkbox"/> Lawn <input type="checkbox"/> Oil field water <input type="checkbox"/> Other		
Very fine sandy clay			9. Casing: Material <b>steel</b> Height: <b>Above</b> or below Threaded <input type="checkbox"/> Welded <input checked="" type="checkbox"/> Surface <b>14</b> in. RMP <b>16</b> <b>PVC</b> Weight <b>36.8</b> lbs./ft. Dia. <b>16</b> in. to <b>250.1</b> ft. depth Wall Thickness <b>1/8</b> in. or Dia. _____ in. to _____ ft. depth Gauge No. <b>219</b>		
Brown sandy <del>clay</del> clay			10. Screen: Manufacturer's name <b>Lakewood</b> <b>Pipe of Texas</b> Type <b>steel</b> Dia. <b>16"</b> Slot/gauze <b>3/16</b> Length <b>129.11</b> Set between <b>370.1</b> ft. and <b>490</b> ft. _____ ft. and _____ ft.		
Medium to coarse sand w/clay breakers			11. Static water level: _____ mo./day/yr. <b>165</b> ft. below land surface Date <b>6-15-76</b>		
Sandy clay w/medium sand strips			12. Pumping level below land surfaces: <b>191.6</b> ft. after <b>7.5</b> hrs. pumping <b>1613</b> g.p.m. _____ ft. after _____ hrs. pumping _____ g.p.m. Estimated maximum yield <b>2000</b> g.p.m.		
Medium to coarse sand w/clay breakers			13. Water sample submitted: _____ mo./day/yr. Yes <input checked="" type="checkbox"/> No <input type="checkbox"/> Date _____		
Sandy clay w/medium sand strips			14. Well head completion: <b>NA</b> _____ Pitless adapter _____ Inches above grade		
Medium to coarse sand w/clay breakers			15. Well grouted? <input checked="" type="checkbox"/> <b>X</b> With: _____ Neat cement <input checked="" type="checkbox"/> Bentonite _____ Concrete Depth: From <b>0</b> ft. to <b>10</b> ft.		
Sandy clay w/fine sand strips			16. Nearest source of possible contamination: <b>NA</b> ft. _____ Direction _____ Type _____ Well disinfected upon completion? _____ Yes <input checked="" type="checkbox"/> No <input type="checkbox"/>		
Medium to coarse sand w/clay breakers			17. Pump: <input checked="" type="checkbox"/> <b>X</b> Not installed Manufacturer's name _____ Model number _____ HP _____ Volts _____ Length of drop pipe _____ ft. capacity _____ g.p.m. Type: <input type="checkbox"/> Submersible <input type="checkbox"/> Turbine <input type="checkbox"/> Jet <input type="checkbox"/> Reciprocating <input type="checkbox"/> Centrifugal <input type="checkbox"/> Other		
Sandy clay, lime shale & fine sand strips			20. Water well contractor's certification: This well was drilled under my jurisdiction and this report is true to the best of my knowledge and belief. <b>Houck Bros. Drlg. Co. 164</b> Business name <b>Box 487, Ulysses, Ks.</b> License No. _____ Address _____ Signed <b>M. Beard</b> Date <b>11/3/76</b> Authorized representative		
Medium clay, lime shale & fine sand strips					
Sandy clay, lime shale & fine sand strips					
(Use a second sheet if needed)					
18. Elevation:  Topography: <input checked="" type="checkbox"/> Hill <input type="checkbox"/> Slope <input type="checkbox"/> Upland <input type="checkbox"/> Valley		19. Remarks: <b>120 feet W. A. Brown Free-Flu perforation set between 250.1 feet and 370.1 feet.</b>			

31 370 24 SE 1/4 SW 1/4