


1 LOCATION OF WATER WELL: County: **STEVENS** Fraction: **NW** 1/4 **NE** 1/4 Section Number: **3** Township Number: **T 31 S** Range Number: **R 38 E** **(NW)**

Distance and direction from nearest town or city street address of well if located within city?
FROM HUGOTON: 8 N TO RADIO TOWER, 9 W, 2 N, 1 E, 2 N & 1.5 E, SOUTH INTO LOC.

2 WATER WELL OWNER: **SEABOARD FARMS CO.** WELL # **1**
 RR#, St. Address, Box #: **P.O. BOX 1207** Board of Agriculture, Division of Water Resources
 City, State, ZIP Code: **GUYMON, OK 73942** Application Number:

3 LOCATE WELL'S LOCATION WITH AN "X" IN SECTION BOX:

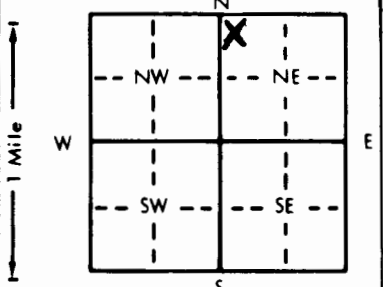

4 DEPTH OF COMPLETED WELL: **400** ft. ELEVATION: ft.
 Depth(s) Groundwater Encountered 1. **245** ft. 2. ft. 3. ft.
 WELL'S STATIC WATER LEVEL: **245** ft. below land surface measured on **11-06-95**
 Pump test data: Well water was **250** ft. after **1** hours pumping **90** gpm
 Est. Yield: **90** gpm; Well water was ft. after hours pumping gpm
 Bore Hole Diameter: **11** in. to **400** ft., and in. to ft.
 WELL WATER TO BE USED AS:
 5 Public water supply 8 Air conditioning 11 Injection well
 1 Domestic **(3)** Feedlot 6 Oil field water supply 9 Dewatering **(12)** Other (Specify below)
 2 Irrigation 4 Industrial 7 Lawn and garden only 10 Monitoring well **HOG FARM**
 Was a chemical/bacteriological sample submitted to Department? Yes.....No **X**..... If yes, mo/day/yr sample was submitted
 Water Well Disinfected? Yes **X** No

5 TYPE OF BLANK CASING USED:
 1 Steel 3 RMP (SR) 5 Wrought iron 8 Concrete tile CASING JOINTS: Glued **X** Clamped
(2) PVC 4 ABS 6 Asbestos-Cement 9 Other (specify below) Welded
 7 Fiberglass Threaded

Blank casing diameter: **11** in. to **400** ft., Dia in. to ft., Dia in. to ft.
 Casing height above land surface: **24** in., weight **2.902** lbs./ft. Wall thickness or gauge No. **280 SDR 21**

TYPE OF SCREEN OR PERFORATION MATERIAL:
 1 Steel 3 Stainless steel 5 Fiberglass **(7)** PVC 10 Asbestos-cement
 2 Brass 4 Galvanized steel 6 Concrete tile 8 RMP (SR) 11 Other (specify)
 9 ABS 12 None used (open hole)

SCREEN OR PERFORATION OPENINGS ARE:
 1 Continuous slot 3 Mill slot 5 Gauzed wrapped **(8)** Saw cut 11 None (open hole)
 2 Louvered shutter 4 Key punched 6 Wire wrapped 9 Drilled holes
 7 Torch cut 10 Other (specify)

SCREEN-PERFORATED INTERVALS: From **340** ft. to **400** ft., From ft. to ft.
 GRAVEL PACK INTERVALS: From **240** ft. to **400** ft., From ft. to ft.

6 GROUT MATERIAL: **(1)** Neat cement 2 Cement grout 3 Bentonite **(4)** Other **HOLE PLUG**
 Grout Intervals: From **0** ft. to **16** ft., From ft. to ft., From ft. to ft.

What is the nearest source of possible contamination:
 1 Septic tank 4 Lateral lines 7 Pit privy 10 Livestock pens 14 Abandoned water well
 2 Sewer lines 5 Cess pool 8 Sewage lagoon 11 Fuel storage 15 Oil well/Gas well
 3 Watertight sewer lines 6 Seepage pit 9 Feedyard 12 Fertilizer storage 16 Other (specify below)
 13 Insecticide storage

Direction from well? How many feet?

FROM	TO	LITHOLOGIC LOG	FROM	TO	PLUGGING INTERVALS
0	2	TOP CLAY	265	275	CLAY
2	60	CLAY	275	300	COARSE SAND
60	70	COARSE SAND	300	329	SAND W/CLAY STREAKS
70	80	CLAY	329	374	COARSE SAND
80	107	SANDY CLAY	374	387	SANDY CLAY & YELLOW CLAY
107	132	CLAY	387	400	YELLOW CLAY
132	140	SAND			
140	145	CALICHE ROCK			
145	159	COARSE SAND			
159	165	SAND W/CLAY STREAKS			
165	178	CLAY			
178	193	CLAY & SANDY CLAY			
193	230	SAND			
230	235	CLAY			
235	265	SANDY CLAY			

7 CONTRACTOR'S OR LANDOWNER'S CERTIFICATION: This water well was **(1)** constructed, (2) reconstructed, or (3) plugged under my jurisdiction and was completed on (mo/day/year) **11-06-95** and this record is true to the best of my knowledge and belief. Kansas Water Well Contractor's License No. **KWCL-430** This Water Well Record was completed on (mo/day/yr) **11-06-95** under the business name of **HOWARD DRIG.CO.BOX 806 BEAVER, OK 73932** by (signature) *[Signature]*