


1 LOCATION OF WATER WELL: Fraction NW 1/4 NW 1/4 NE 1/4 Section Number 3 Township Number T 31 S Range Number R 38 EW
 County: STEVENS

Distance and direction from nearest town or city street address of well if located within city?

FROM HUGOTON: 14 MILES NORTHWEST

2 WATER WELL OWNER: SEABOARD FARMS CO.
 RR#, St. Address, Box #: P.O. BOX 1207 Board of Agriculture, Division of Water Resources
 City, State, ZIP Code: GUYMON, OK 73942 Application Number:

3 LOCATE WELL'S LOCATION WITH AN "X" IN SECTION BOX:

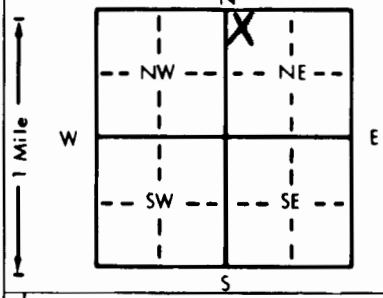

4 DEPTH OF COMPLETED WELL: 400 ft. ELEVATION:
 Depth(s) Groundwater Encountered 1. 250 ft. 2. ft. 3. ft.
 WELL'S STATIC WATER LEVEL: 250 ft. below land surface measured on mo/day/yr 11-09-95
 Pump test data: Well water was 270 ft. after 1 hours pumping 90 gpm
 Est. Yield 90 gpm: Well water was ft. after hours pumping gpm
 Bore Hole Diameter: 11 in. to 400 ft., and in. to ft.
 WELL WATER TO BE USED AS:
 5 Public water supply 8 Air conditioning 11 Injection well
 1 Domestic 3 Feedlot 6 Oil field water supply 9 Dewatering 12 Other (Specify below)
 2 Irrigation 4 Industrial 7 Lawn and garden only 10 Monitoring well HOG FARM
 Was a chemical/bacteriological sample submitted to Department? Yes.....No X.....; If yes, mo/day/yr sample was submitted
 Water Well Disinfected? Yes X No

5 TYPE OF BLANK CASING USED:
 1 Steel 3 RMP (SR) 5 Wrought iron 8 Concrete tile CASING JOINTS: Glued X Clamped
2 PVC 4 ABS 6 Asbestos-Cement 9 Other (specify below) Welded
 7 Fiberglass Threaded

Blank casing diameter 6 in. to 400 ft., Dia in. to ft., Dia in. to ft.
 Casing height above land surface 24 in., weight 2.902 lbs./ft. Wall thickness or gauge No. 280 SDR 21

TYPE OF SCREEN OR PERFORATION MATERIAL:
 1 Steel 3 Stainless steel 5 Fiberglass 7 PVC 10 Asbestos-cement
 2 Brass 4 Galvanized steel 6 Concrete tile 8 RMP (SR) 11 Other (specify)
 9 ABS 12 None used (open hole)

SCREEN OR PERFORATION OPENINGS ARE:
 1 Continuous slot 3 Mill slot 5 Gauzed wrapped 8 Saw cut 11 None (open hole)
 2 Louvered shutter 4 Key punched 6 Wire wrapped 9 Drilled holes
 7 Torch cut 10 Other (specify)

SCREEN-PERFORATED INTERVALS: From 340 ft. to ft., From 400 ft. to ft.
 From ft. to ft., From ft. to ft.
 GRAVEL PACK INTERVALS: From 240 ft. to ft., From 400 ft. to ft.
 From ft. to ft., From ft. to ft.

6 GROUT MATERIAL: 1 Neat cement 2 Cement grout 3 Bentonite 4 Other HOLE PLUG
 Grout Intervals: From 16 ft. to ft., From ft. to ft., From ft. to ft.

What is the nearest source of possible contamination:
 1 Septic tank 4 Lateral lines 7 Pit privy 10 Livestock pens 14 Abandoned water well
 2 Sewer lines 5 Cess pool 8 Sewage lagoon 11 Fuel storage 15 Oil well/Gas well
 3 Watertight sewer lines 6 Seepage pit 9 Feedyard 12 Fertilizer storage 16 Other (specify below)
 13 Insecticide storage

Direction from well? How many feet?

FROM	TO	LITHOLOGIC LOG	FROM	TO	PLUGGING INTERVALS
0	2	TOP CLAY	220	245	CLAY W/SAND STREAKS
2	62	CLAY	245	270	COARSE SAND
62	74	SANDY CLAY & SAND	270	278	CLAY
74	80	CLAY	278	283	SANDY CLAY & SAND
80	104	CLAY & SANDY CLAY	283	304	COARSE SAND W/CLAY STREAKS
104	118	SAND	304	364	COARSE SAND
118	123	CLAY	364	393	COARSE SAND & SMALL GRAVEL
123	139	COARSE SAND	393	400	YELLOW CLAY W/RED STREAKS
139	142	CALICHE ROCK			
142	152	CLAY & SANDY CLAY			
152	165	SAND & SANDY CLAY			
165	175	SAND			
175	186	CLAY			
186	196	CLAY & SANDY CLAY			
196	220	CLAY W/SAND STREAKS			

7 CONTRACTOR'S OR LANDOWNER'S CERTIFICATION: This water well was (1) constructed, (2) reconstructed, or (3) plugged under my jurisdiction and was completed on (mo/day/year) 11-09-95 and this record is true to the best of my knowledge and belief. Kansas Water Well Contractor's License No. KWCL-430 This Water Well Record was completed on (mo/day/yr) 11-09-95 under the business name of HOWARD DRUG CO. BOX 806 BEAVER, OK 73932 by (signature) *Howard*