


1	LOCATION OF WATER WELL: Stevens	Fraction $\frac{1}{4}$ $\frac{1}{4}$ SW $\frac{1}{4}$	Section Number 2	Township Number 31	Range Number 38
---	---	---	----------------------------	------------------------------	---------------------------

Distance and direction from nearest town or city street address of well if located within city? **From northeast corner of Hugoton - 13 miles north on Hwy. 25 & 4 miles west to SE corner of section**

2	WATER WELL OWNER: Crooked River JV Route 1 - Box 74 RR #, St. Address, Box #: City, State, ZIP Code : Richfield, Kansas 67953	Board of Agriculture, Division of Water Resources Application Number:
---	--	--

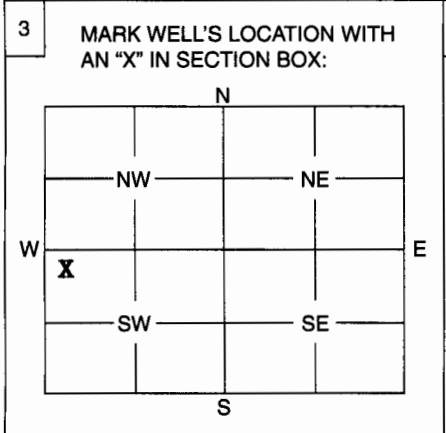

4 DEPTH OF WELL **170** ft.
 WELL'S STATIC WATER LEVEL **none** ft.
 WELL WAS USED AS:
 1 Domestic 5 Public Water Supply 9 Dewatering
 2 Irrigation 6 Oil Field Water Supply 10 Monitoring Well
 3 Feedlot 7 Domestic (Lawn & Garden) 11 Injection Well
 4 Industrial 8 Air Conditioning 12 Other **Stock**.....

Was a chemical / bacteriological sample submitted to Department? Yes No **X**.....
 If yes, mo/day/yr sample was submitted

Water Well Disinfected: Yes **X**..... No

5 TYPE OF BLANK CASING USED:

<input checked="" type="checkbox"/> 1 Steel	<input type="checkbox"/> 3 RMP (SR)	<input type="checkbox"/> 5 Wrought	<input type="checkbox"/> 7 Fiberglass	<input type="checkbox"/> 9 Other (Specify below)
<input type="checkbox"/> 2 PVC	<input type="checkbox"/> 4 ABS	<input type="checkbox"/> 6 Asbestos-Cement	<input type="checkbox"/> 8 Concrete Tile	

Blank casing diameter **5** in. Was casing pulled? Yes No **X** If yes, how much

Casing height above or below land surface **36** in. **below**

6 GROUT PLUG MATERIAL: 1 Neat cement 2 Cement grout 3 Bentonite 4 Other

Grout Plug Intervals: From **3** ft. to **170** ft., From ft. to ft., From to ft.

What is the nearest source of possible contamination:

1 Septic tank	6 Seepage pit	11 Fuel storage	16 Other (specify below)
2 Sewer lines	7 Pit privy	12 Fertilizer storage	
3 Watertight sewer lines	8 Sewage lagoon	13 Insecticide storage	
4 Lateral lines	9 Feedyard	14 Abandoned water well	
5 Cess pool	10 Livestock pens	15 Oil well/Gas well	

Direction from well? How many feet?

FROM	TO	PLUGGING MATERIALS
0 ft	3 ft	Top soil
3 ft	170 ft	Cement Grout

7 CONTRACTOR'S OF LANDOWNER'S CERTIFICATION: This water well was plugged under my jurisdiction and was completed on (mo/day/year) **6/22/05** and this record is true to the best of my knowledge and belief. Kansas Water Well Contractor's License No. **208** This Water Well Record was completed on (mo/day/year) **6/23/05** under the business name of **Minter-Wilson Drilling Co., Inc.**
 by (signature) *Arvi Keller*

INSTRUCTIONS: Use typewriter or ball point pen. Please press firmly and print clearly. Please fill in blanks, underline or circle the correct answers. Send top three copies to Kansas Department of Health and Environment, Bureau of Water, Geology Section, 1000 SW Jackson St., Ste. 420, Topeka, Kansas 66612-1367. Telephone: 785/296-5522. Send one to Water Well Owner and retain one for your records.