


1 LOCATION OF WATER WELL: Fraction Section Number Township Number Range Number
 COUNTY: 095 STEVENS NW 1/4 SE 1/4 NW 1/4 17 T 31 S R 38 W

Distance and direction from nearest town or city street address of well if located within city?
 FROM MOSCOW; APPX 14 3/4 MILRS WEST & 1 3/4 MILES NORTH

2 WATER WELL OWNER: TIMMONS FAMILY PARTNER.
 RR#, St. Address, Box # : 1004 S. VAN BUREN ST Board of Agriculture, Division of Water Resources
 City, State, ZIP code : HUGOTON, KS 67951-2838 Application Number: 27,430

3 LOCATE WELL'S LOCATION WITH AN "X" IN SECTION BOX:

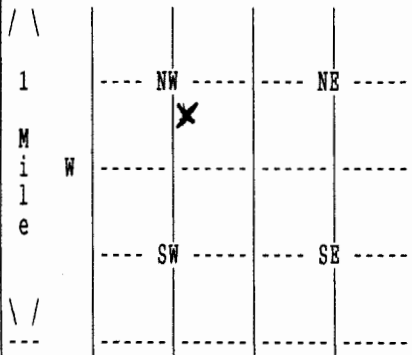

4 DEPTH OF COMPLETED WELL 450 ELEVATION: 0
 Depth(s) Groundwater Encountered 1. 0 ft. 2. 0 ft. 3. 0 ft.

WELL'S STATIC WATER LEVEL 260 ft. below land surface measured on mo/day/yr 02/21/05
 Pump test data: Well water was 306 ft. after 4 hours pumping 1700 gpm

Estimated Yield 0 gpm: Well water was 0 ft. after 0 hours pumping 0 gpm

Bore Hole Diameter 24 in. to 450 ft., and in. to 0 ft.

WELL WATER TO BE USED AS: 02 IRRIGATION

Was a chemical/bacteriological sample submitted to department? No ;
 If yes, mo/day/yr sample was submitted Water well disinfected? Yes

5 TYPE OF BLANK CASING USED: 01 STEEL CASING JOINTS: WELDED
 Blank casing diameter 16 in. to 450 ft., Dia in. to 0 ft., Dia in. to 0 ft.
 Casing height above land surface 12 in., weight 42 lbs/ft. Wall thickness or gauge No. .250
 TYPE OF SCREEN OR PERFORATION MATERIAL: 01 STEEL
 SCREEN OR PERFORATION OPENINGS ARE: 01 CONT. SLOT

SCREEN PERFORATED INTERVALS: From 305 ft. to 445 ft., From 0 ft. to 0 ft.
 From 0 ft. to 0 ft., From 0 ft. to 0 ft.
 GRAVEL PACK INTERVALS: From 20 ft. to 450 ft., From 0 ft. to 0 ft.
 From 0 ft. to 0 ft., From 0 ft. to 0 ft.

6 GROUT MATERIAL 03 BENTONITE
 Grout Intervals: From 0 ft. to 20 ft., From 0 ft. to 0 ft., From 0 ft. to 0 ft.
 What is the nearest source of possible contamination: NONE OBSERVED
 Direction from well? How many feet? 0

FROM	TO	LITHOLOGIC LOG	FROM	TO	PLUGGING INTERVALS
0	2	02 SILT			
2	80	04 SANDY CLAY 20 LIMESTONE 05 SAND			
80	88	05 SAND 13 FINE GRAVEL			
88	105	04 SANDY CLAY 20 LIMESTONE			
105	126	07 FINE SAND 08 MEDIUM SAND			
126	140	04 SANDY CLAY 20 LIMESTONE			
140	170	05 SAND 13 FINE GRAVEL			
170	217	04 SANDY CLAY			
217	245	05 SAND 13 FINE GRAVEL			
245	257	04 SANDY CLAY			

7 CONTRACTOR'S OR LANDOWNER'S CERTIFICATION: This water well was Constructed under my jurisdiction and was completed on (mo/day/year) 09/16/05 and this record is true to the best of my knowledge and belief. Kansas Water Well Contractor's License No. 145 This Water Well Record was completed on (mo/day/yr) 10/13/05 under the business name of HENKLE DRILLING & SUPPLY by (signature)

1 LOCATION OF WATER WELL: COUNTY: 095 STEVENS	Fraction NW 1/4 SE 1/4 NW 1/4	Section Number 17	Township Number T 31 S	Range Number R 38 W
--	----------------------------------	----------------------	---------------------------	------------------------

2 WATER WELL OWNER: TIMMONS FAMILY PARTNER.
RR#, St. Address, Box # : 1004 S. VAN BUREN ST
City, State, ZIP code : HUGOTON, KS 67951-2838

Board of Agriculture, Division of Water Resources
Application Number: 27,430

FROM	TO	LITHOLOGIC LOG
257	273	05 SAND
273	277	04 SANDY CLAY 05 SAND
277	302	05 SAND
302	305	04 SANDY CLAY
305	310	05 SAND
310	317	07 FINE SAND 08 MEDIUM SAND 01 CLAY
317	328	05 SAND
328	332	04 SANDY CLAY
332	342	05 SAND
342	350	07 FINE SAND 08 MEDIUM SAND
350	373	05 SAND
373	390	05 SAND 01 CLAY
390	405	05 SAND 28 ROCK
405	411	04 SANDY CLAY
411	445	05 SAND 01 CLAY
445	450	31 CALICHE

7 CONTRACTOR'S OR LANDOWNER'S CERTIFICATION: This water well was Constructed under my jurisdiction and was completed on (mo/day/year) 09/16/05 and this record is true to the best of my knowledge and belief. Kansas
Water Well Contractor's License No. 145 This Water Well Record was completed on (mo/day/yr) 10/13/05
under the business name of HENKLE DRILLING & SUPPLY by (signature) *Daniel R. Smith*