

**CORRECTION(S) TO WATER WELL RECORD (WWC-5)**

(to rectify lacking or incorrect information)

County: Stevens

**Location listed as:**

Section-Township-Range: 20-315-38 W

Fraction (  $\frac{1}{4}$   $\frac{1}{4}$   $\frac{1}{4}$ ): None Given

**Location changed to:**

20-315-38 W

SR SE

**Other changes:** Initial statements: \_\_\_\_\_

Changed to: \_\_\_\_\_

Comments: \_\_\_\_\_

verification method: Legal description, position on plot map, and mapping tool & aerial photos on KGS website.


initials: ARD date: 10/16/2006

submitted by: Kansas Geological Survey, Data Resources Library, 1930 Constant Ave., Lawrence, KS 66047-3726  
to: Kansas Dept of Health & Environment, Bureau of Water, 1000 SW Jackson, Suite 420, Topeka, KS 66612-1367.

1	LOCATION OF WATER WELL: County: <u>Stevens</u>	Fraction <u>1/4 1/4 1/4</u>	Section Number <u>20</u>	Township Number <u>31 S</u>	Range Number <u>38 W</u>
---	---	--------------------------------	-----------------------------	--------------------------------	-----------------------------

Distance and direction from nearest town or city street address of well if located within city?

2 WATER WELL OWNER: Steve Tarbet  
 RR#, St. Address, Box #: 1300 E. Michigan  
 City, State, ZIP Code: Ulysses KS 67880  
 Board of Agriculture, Division of Water Resources  
 Application Number:

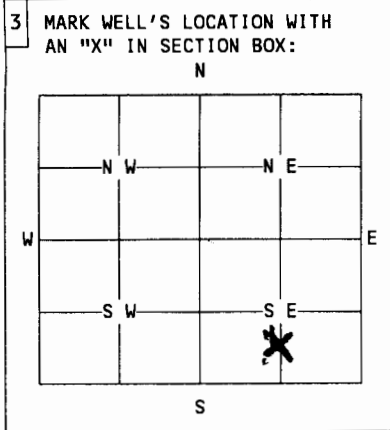

4 DEPTH OF WELL.....172.....ft.  
 WELL'S STATIC WATER LEVEL...dry.....ft.  
 WELL WAS USED AS:  
 1 Domestic      5 Public Water Supply      9 Dewatering  
 2 Irrigation    6 Oil Field Water Supply    10 Monitoring Well  
 3 Feedlot       7 Lawn and Garden Only    11 Injection Well  
 4 Industrial    8 Air Conditioning        12 Other: live stock.....  
 Was a chemical/bacteriological sample submitted to Department? Yes....No...X..  
 If yes, mo/day/yr sample was submitted.....  
 Water Well Disinfected: Yes...X... No.....

5 TYPE OF BLANK CASING USED:  
 Steel    3 RMP (SR)    5 Wrought    7 Fiberglass    9 Other (specify below)  
 PVC    4 ABS    6 Asbestos-Cement    8 Concrete Tile  
 Blank casing diameter...6".....in.    Was casing pulled? Yes...X... No..... If yes, how much...5'.....  
 Casing height above or below land surface.....in.

6 GROUT PLUG MATERIAL: 1 Neat cement    2 Cement grout    3 Bentonite    4 Other.....  
 Grout Plug Intervals: From.....ft. to.....ft., From.....ft. to.....ft., From..... to.....ft.  
 What is the nearest source of possible contamination:  
 1 Septic tank    6 Seepage pit    11 Fuel storage    16 Other (specify below)  
 2 Sewer lines    7 Pit privy    12 Fertilizer storage    .....salt water tank.....  
 3 Watertight sewer lines    8 Sewage lagoon    13 Insecticide storage  
 4 Lateral lines    9 Feedyard    14 Abandoned water well  
 5 Cess Pool    10 Livestock pens    15 Oil well/Gas well

Direction from well? 10' salt water tanks is South How many feet? 50 ft.  
10. well located in livestock pasture.

FROM	TO	PLUGGING MATERIALS
<u>5'</u>	<u>172'</u>	<u>concrete grout</u>

7 CONTRACTOR'S OR LANDOWNER'S CERTIFICATION: This water well was plugged under my jurisdiction and was completed on (mo/day/year) 9-9-00 and this record is true to the best of my knowledge and belief. Kansas Water Well Contractor's License No. LANDOWNER This Water Well Record was completed on (mo/day/year) ..... under the business name of TARBET CONST. CO INC by (signature) Steve Tarbet

INSTRUCTIONS: Use typewriter or ball point pen. Please press firmly and print clearly. Please fill in blanks, underline or circle the correct answers. Send top three copies to Kansas Department of Health and Environment, Bureau of Water, Topeka, Kansas 66620-0001. Telephone: 785/296-3565. Send one to Water Well Owner and retain one for your records.