


1 LOCATION OF WATER WELL: County: Stevens Fraction: SE 1/4 SE 1/4 SW 1/4 Section Number: 2 Township Number: T 31 S Range Number: R 38 E/W

Distance and direction from nearest town or city street address of well if located within city?
14 miles south 3 1/2 west of Ulysses, KS

2 WATER WELL OWNER: Glenn Tuttle
 RR#, St. Address, Box #: Route 2
 City, State, ZIP Code: Ulysses, Kansas 67880
 Board of Agriculture, Division of Water Resources
 Application Number:

3 LOCATE WELL'S LOCATION WITH AN "X" IN SECTION BOX: 4 DEPTH OF COMPLETED WELL: 257 ft. ELEVATION: slope

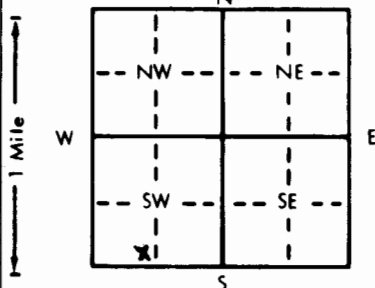

Depth(s) Groundwater Encountered 1. 189 ft. 2. ft. 3. ft.
 WELL'S STATIC WATER LEVEL 189 ft. below land surface measured on mo/day/yr 7/5/89
 Pump test data: Well water was 195 ft. after 4 hours pumping 10 gpm
 Est. Yield 30 gpm: Well water was ft. after hours pumping gpm
 Bore Hole Diameter 9 7/8 in. to 257 ft., and in. to ft.
 WELL WATER TO BE USED AS:
 1 Domestic 3 Feedlot 6 Oil field water supply 9 Dewatering 12 Other (Specify below)
 2 Irrigation 4 Industrial 7 Lawn and garden only 10 Monitoring well pasture
 Was a chemical/bacteriological sample submitted to Department? Yes No X; If yes, mo/day/yr sample was submitted
 Water Well Disinfected? Yes X No

5 TYPE OF BLANK CASING USED:
 1 Steel 3 RMP (SR) 5 Wrought iron 8 Concrete tile CASING JOINTS: Glued X Clamped
 2 PVC 4 ABS 6 Asbestos-Cement 9 Other (specify below) & riveted Welded
 7 Fiberglass Threaded

Blank casing diameter 5 in. to 217 ft., Dia. in. to ft., Dia. in. to ft.
 Casing height above land surface 18 in., weight lbs./ft. Wall thickness or gauge No. schedule 200

TYPE OF SCREEN OR PERFORATION MATERIAL:
 1 Steel 3 Stainless steel 5 Fiberglass 8 RMP (SR) 10 Asbestos-cement 11 Other (specify)
 2 Brass 4 Galvanized steel 6 Concrete tile 9 ABS 12 None used (open hole)

SCREEN OR PERFORATION OPENINGS ARE:
 1 Continuous slot 3 Mill slot 5 Gauzed wrapped 8 Saw cut 11 None (open hole)
 2 Louvered shutter 4 Key punched 6 Wire wrapped 9 Drilled holes
 7 Torch cut 10 Other (specify)

SCREEN-PERFORATED INTERVALS: From 217 ft. to 257 ft., From ft. to ft.
 GRAVEL PACK INTERVALS: From 10 ft. to 257 ft., From ft. to ft.

6 GROUT MATERIAL: 1 Neat cement 2 Cement grout 3 Bentonite 4 Other
 Grout Intervals: From 0 ft. to 10 ft., From ft. to ft., From ft. to ft.

What is the nearest source of possible contamination:
 1 Septic tank 4 Lateral lines 7 Pit privy 10 Livestock pens 14 Abandoned water well
 2 Sewer lines 5 Cess pool 8 Sewage lagoon 11 Fuel storage 15 Oil well/Gas well
 3 Watertight sewer lines 6 Seepage pit 9 Feedyard 12 Fertilizer storage 16 Other (specify below)
 13 Insecticide storage in a pasture

Direction from well? How many feet?

FROM	TO	LITHOLOGIC LOG	FROM	TO	PLUGGING INTERVALS
0	2	Surface			
2	65	Clay w/rock shells			
65	105	Medium cemented sand w/loose strips			
105	150	Medium sand w/clay breakers			
150	255	Medium to coarse sand			
255	300	Sandy clay			
300	315	Yellow chalk and sandstone			

7 CONTRACTOR'S OR LANDOWNER'S CERTIFICATION: This water well was (1) constructed, (2) reconstructed, or (3) plugged under my jurisdiction and was completed on (mo/day/year) 7/5/89 and this record is true to the best of my knowledge and belief. Kansas Water Well Contractor's License No. 164 This Water Well Record was completed on (mo/day/yr) Sept. 8, 1989 under the business name of Houck Bros. Drilling Co. by (signature) M. Beard