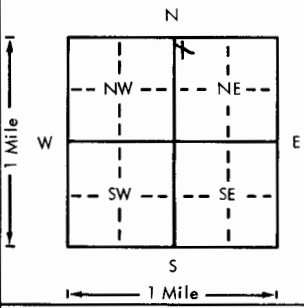


USE TYPEWRITER OR BALL POINT PEN-PRESS FIRMLY, PRINT CLEARLY.

WATER WELL RECORD
KSA 82a-1201-1215

Kansas Department of Health and Environment-Division of Environment
(Water well Contractors)
Topeka, Kansas 66620

1. Location of well: County: Stevens		Fraction: NW 1/4 NW 1/4 NE 1/4		Section number: 7		Township number: T 31 S R 38 E/W		Range number: 38	
2. Distance and direction from nearest town or city: 5 west, 13 south Street address of well location if in city: 1 west, 1 south 1 1/2 west of Ulysses, Ks.				3. Owner of well: Larco Inc. R.R. or street: % Paul Sundgren City, state, zip code: 112 S. Jackson, Hugoton, Ks. 67951					
4. Locate with "X" in section below: Sketch map: 				6. Bore hole dia. <u>27</u> in. Completion date _____ Well depth <u>485</u> ft. <u>9-25-76</u>					
				7. <input type="checkbox"/> Cable tool <input checked="" type="checkbox"/> Rotary <input type="checkbox"/> Driven <input type="checkbox"/> Dug <input type="checkbox"/> Hollow rod <input type="checkbox"/> Jetted <input type="checkbox"/> Bored <input type="checkbox"/> Reverse rotary					
				8. Use: <input type="checkbox"/> Domestic <input type="checkbox"/> Public supply <input type="checkbox"/> Industry <input checked="" type="checkbox"/> Irrigation <input type="checkbox"/> Air conditioning <input type="checkbox"/> Stock <input type="checkbox"/> Lawn <input type="checkbox"/> Oil field water <input type="checkbox"/> Other					
				9. Casing: Material <u>steel</u> Height: (Above or below) _____ Threaded _____ Welded <input checked="" type="checkbox"/> Surface <u>14</u> in. RMP _____ PVC _____ Weight <u>36.8</u> lbs./ft. Dia. <u>16</u> in. to <u>235.11</u> ft. depth Wall thickness: inches or Dia. _____ in. to _____ ft. depth gage No. <u>219</u>					
5. Type and color of material				From		To			
Surface				0		2			
Clay & fine sand				2		16			
Clay				16		65			
Sandy clay				65		95			
Clay & hard lime shells				95		130			
Medium sand				130		140			
Sandy clay				140		160			
Fine to mediums sand w/clarge clay breakers				160		190			
Sandy clay				190		210			
Sandy clay w/sand strips <u>30/ft.</u>				210		236			
Coarse sand <u>30 feet</u>				236		266			
Brown & gray clay, tight				266		330			
Sandy clay/w/small sand strips				330		337			
Medium to coarse sand <u>8 ft.</u>				337		345			
Sandy clayw/sand strips <u>12 ft.</u>				345		378			
Brwon clay				378		400			
Medium to coarse sand <u>28 ft.</u>				400		428			
Clay				428		437			
Medium to coarse sand <u>14 ft.</u>				437		451			
Sandy clay w/fine to medium sand <u>7 ft.</u>				451		463			
Clay and rock				463		468			
Clay and fine sand (Use a second sheet if needed)				468		485			
18. Elevation:		19. Remarks:							
Topography: <input type="checkbox"/> Hill <input checked="" type="checkbox"/> Slope <input type="checkbox"/> Upland <input type="checkbox"/> Valley									
20. Water well contractor's certification: This well was drilled under my jurisdiction and this report is true to the best of my knowledge and belief. Houck Bros. Drlg. Co. 164 Business no Box 487, Ulysses, Ks. License No. _____ Address _____ Signed <u>M. Beard</u> Date <u>11/16/76</u> Authorized representative									

3
L
3
8
E
Z
1/4
1/4
1/4
1/4