USE TYPEWRITER OR BALL POINT PEN-PRESS FIRMLY, PRINT CLEARLY.

T R EW sec 1/4 1/4 1/4 No.

WATER WELL RECORD
KSA 82a-1201-1215

Kansas State Dept. Of Health
(Water Well Contractors)
Forbes-Bldg. 740
Topeka, Kansas 66620

1 Location of well:	County	Township name	Fraction	Section number	Town number	Range number
	Stevens		SW¼ SW¼ SE¼	11	T31S	R38 W

Distance and direction from nearest town or city: 12 M. 4½ W of Hugoton K.

Street address of well location if in city:

3 Owner of well: Warren Spikes

Address: City Box Hugoton, Kansas 67951

Locate with "X" in section below: Sketch map:

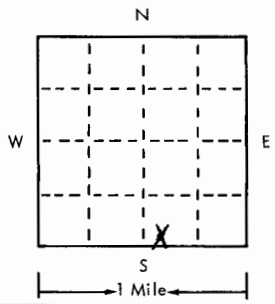

4 Well depth: 260 ft. Date of completion 3-26-75
Well diameter 10 in.

5 ☐ Cable tool ☒ Rotary ☐ Driven ☐ Dug ☐ Hollow rod ☐ Jetted ☐ Bored ☐ Reverse rotary

6 Use: ☒ Domestic ☐ Public supply ☐ Industry ☐ Irrigation ☐ Air conditioning ☐ Commercial ☐ Test well ☒ Stock

7 Casing: Material PVC. Height: above/below
Threaded ☐ Welded ☐ Surface 18 in.
Diam. 5 in. to 260 ft. depth Weight 160 lbs./ft. 100
___ in. to ___ ft. depth Drive shoe? ☐ Yes ☒ No

2 Type and color of material	From	To
Top soil Gray Loam	0	3
Calichie Mixed with brown silts	3	18
Silts & joint Clays brown	18	44
Silts & small redish silt balls	44	80
clay balls & silts jip rock some sand brown	80	120
Clay Shelf brown	120	124
joint Clays some sand brown	124	136
Corse Sand & fine Gravel brown	136	180
Clay balls Tan & sand corse brown	180	196
fine Gravel some Clay balls Tan	196	220
fine Gravel & Corse sand some C. balls	220	260
(use a second sheet if needed)		

8 Screen:
Manufacturer PumPco Polyvinylchlor.
Type PVC. Dia. 5
Slot/gauze 16 Length 40'
Set between 160 ft. and 180 ft. 20
~~Fittings~~: 240 & 260' 20
Gravel pack ☒ Yes ☐ No Size range of material 16 to 8

9 Static water level:
140 ft. below land surface Date 3-22-75

10 Pumping level below land surfaces:
140 ft. after ___ hrs. pumping 9½ g.p.m.
___ ft. after ___ hrs. pumping ___ g.p.m.
Estimated maximum yield ___ g.p.m.

11 Water sample submitted:
☐ Yes ☒ No Date ___

12 Well head completion: well seal
☐ Pitless adapter ☒ Inches above grade 18

13 Well grouted? ☒ Yes ☐ No
☐ Neat cement ☒ Bentonite ☐ ___
Depth: From 0 ft. to 10 ft.

14 Nearest source of possible contamination:
ft. 50 Direction South Type Corrals
Well disinfected upon completion? ☒ Yes ☐ No

15 Pump: ☐ Not installed
Manufacturer's name PumPco
Model number 528 513 HP ½ Volts 230
Length of drop pipe 180 ft. capacity 9½ g.m.p.
Type:
☒ Submersible ☐ Turbine
☐ Jet ☐ Reciprocating
☐ Certrifugal ☐ Other

16 Remarks: elevation

Topography:
☐ Hill
☒ Slope
☐ Upland
☐ Valley

17 Water well contractor's certification:
This well was drilled under my jurisdiction and this report is true to the best of my knowledge and belief.
Slocum Drilling 127
Business name License No.
Address 516 W 9 Hugoton K.
Signed Paul Slocum Date 3-26-75
Authorized representative

Forward the white, blue and pink copies to the Kansas State Dept. Of Health.

Form WWC-5