


USE TYPEWRITER OR BALL POINT PEN-PRESS FIRMLY, PRINT CLEARLY.

WATER WELL RECORD
KSA 82a-1201-1215

Kansas Department of Health and Environment-Division of Environment
(Water well Contractors)
Topeka, Kansas 66620

1. Location of well: County Stevens Fraction NW 1/4 SE 1/4 NE 1/4 Section number 17 Township number T 31 S R 38 Range number EW

2. Distance and direction from nearest town or city: Hiway Jct. 160 & 25at Ulysses, Ks. 5 miles west-13 south-
Street address of well location if in city: 8/10 west-2 south-1/2 west
3. Owner of well: Mrs. Paul Timmons
R.R. or street: Hugoton, Ks. 67951
City, state, zip code:

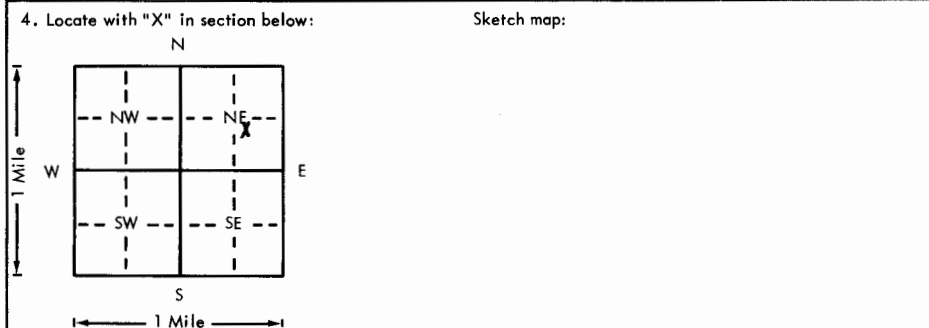

6. Bore hole dia. 27 in. Completion date 6/17/77
Well depth 411 ft.
7. Cable tool Rotary Driven Dug
 Hollow rod Jetted Bored Reverse rotary
8. Use: Domestic Public supply Industry
 Irrigation Air conditioning Stock
 Lawn Oil field water Other
9. Casing: Material steel Height Above or below
Threaded Welded Surface 14 in.
RMP PVC Weight 36.8 lbs./ft.
Dia. 16 in. to 2 1/2 ft. depth Wall Thickness: inches or
Dia. 16 in. to 2 1/2 ft. depth gage No. 219

5. Type and color of material	From	To
Surface	0	2
Brown sandy clay	2	48
Fine to coarse sand & gravel w/clay breakers	48	78
Brown Sandy clay, sandrock strips	78	95
Brown sandy clay, fine to coarse sand strips	95	104
Brown sandy clay, lime shells w/strips of sandrock and gravel	104	121
Very fine to mdeium coarse sand, lime shells w/clay breakers	121	138
Fine to coarse sand, lime shells w/gravel strips	138	174
Brown Clay	174	182
Brown Sandy Clay w/lime shells	182	201
Brown Sandy Clay, fine to coarse sand strips	201	212
Brown Sandy clay	212	226
Fine to coarse sand, small clay breakers	226	268
Brown Sandy Clay	268	283
Brown Sandy clay, embedded sand strips	283	321
Fine to coarse sand w/clay breakers	321	375
Medium Sand and gravel	375	406
Lime shells, yellow chalk, tight sand strips	406	410

10. Screen: Manufacturer's name Lakewood
Pipe of Texas
Type steel Dia. 16"
Slot/gauze 3/16" Length 161.2'
Set between 229.10 ft. and 391 ft.
Gravel pack? Size range of material 1/4 x 5/8"
11. Static water level: 186 ft. below land surface Date 4/4/77
12. Pumping level below land surfaces:
298 ft. after 24 hrs. pumping 1120 g.p.m.
ft. after _____ hrs. pumping _____ g.p.m.
Estimated maximum yield 1250 g.p.m.
13. Water sample submitted: _____ mo./day/yr.
Yes No Date _____
14. Well head completion:
 Pitless adapter 14 Inches above grade
15. Well grouted?
With: Cement Bentonite Concrete
Depth: From 0 ft. to 10 ft.
16. Nearest source of possible contamination:
ft. _____ Direction _____ Type field
Well disinfected upon completion? Yes No
17. Pump: Not installed
Manufacturer's name _____
Model number _____ HP _____ Volts _____
Length of drop pipe _____ ft. capacity _____ g.p.m.
Type:
 Submersible Turbine
 Jet Reciprocating
 Centrifugal Other

18. Elevation: Topography:
 Hill
 Slope
 Upland
 Valley
19. Remarks:

20. Water well contractor's certification:
This well was drilled under my jurisdiction and this report is true to the best of my knowledge and belief.
Houck Bros. Drilling Co. 16
Business name License No. _____
Address Bxo 487, Ulysses, Ks.
Signed M. Beard Date 6/20/77
Authorized representative

3138017 NW SE NE