

USE TYPEWRITER OR BALL POINT PEN-PRESS FIRMLY, PRINT CLEARLY.


T R EW sec 1/4 1/4 1/4 No.

WATER WELL RECORD  
KSA 82a-1201-1215

Kansas State Dept. Of Health  
(Water Well Contractors)  
Forbes-Bldg. 740  
Topeka, Kansas 66620

1 Location of well: County Stevens Township name SE 1/4 SE 1/4 SE 1/4 Fraction SE 1/4 SE 1/4 SE 1/4 Section number 19 Town number 31 Range number 38

Distance and direction from nearest town or city: 18 miles NW 3 Owner of well: Eldon Dale  
Street address of well location if in city: of Hugoton K. Address: City Box  
Hugoton, Kansas 67951

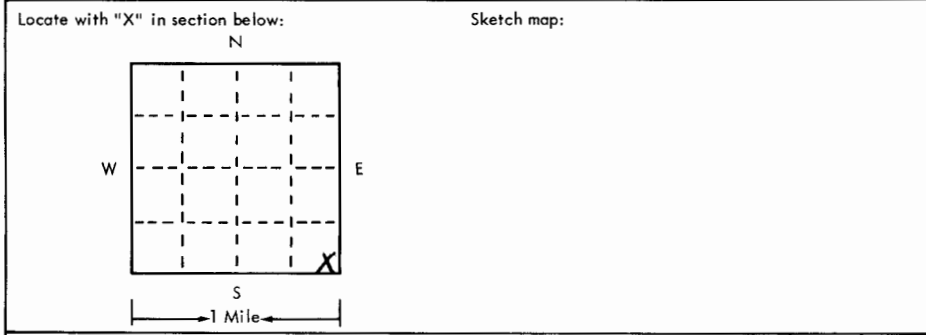

4 Well depth: 360 ft. Date of completion 4-24-76  
Well diameter 10 in.

5  Cable tool  Rotary  Driven  Dug  
 Hollow rod  Jetted  Bored  Reverse rotary

6 Use:  Domestic  Public supply  Industry  
 Irrigation  Air conditioning  Commercial  
 Test well

7 Casing: Material PVC Height: above/below  
Threaded  Welded  Surface 13 in.  
Diam. \_\_\_\_\_ Weight \_\_\_\_\_ lbs./ft. \_\_\_\_\_  
5 in. to 352 ft. depth Drive shoe?  Yes  No  
\_\_\_\_\_ in. to \_\_\_\_\_ ft. depth!

2	Type and color of material	From	To
	top soil light gray silty	0	1'-6"
	clay & caliche	1'-6"	20'
	sand redish + fine	20'	28'
	joint clays - brown + sand brown	28'	40'
	clays brown + waxy	40'	49'
	" " to redish w/ sand texture	49'	66'
	clays w/ silt balls soft + lime rock	66'	148'
	sand coarse w/ clays + flint rock	148'	163'
	joint clays - tan w/ sand coarse brown	163'	232'
	clay shelf	232'	240'
	joint clays + clay balls w/ some sand	240'	320'
	sand coarse + fine gravel w/ some clay	320'	342'
	hard sediment rocks various colored	342'	360'
	with some sand		

8 Screen: Manufacturer Pumpco  
Type 8ch40 Pro Dia. 5  
Slot/gauze 1/2 Length 20  
Set between 342 ft. and 322 ft.  
Fittings: 342 322  
Gravel pack  Yes  No Size range of material 1/4

9 Static water level: 143 ft. below land surface Date 4-24-76

10 Pumping level below land surfaces:  
173 ft. after 2 hrs. pumping 17 g.p.m.  
\_\_\_\_\_ ft. after \_\_\_\_\_ hrs. pumping \_\_\_\_\_ g.p.m.  
Estimated maximum yield \_\_\_\_\_ g.p.m.

11 Water sample submitted:  
 Yes  No Date \_\_\_\_\_

12 Well head completion:  
 Pitless adapter  Inches above grade

13 Well grouted?  Yes  No  
 Neat cement  Bentonite  concrete  
Depth: From 3 ft. to 13 ft.

14 Nearest source of possible contamination: ?  
ft. \_\_\_\_\_ Direction \_\_\_\_\_ Type \_\_\_\_\_  
Well disinfected upon completion?  Yes  No

15 Pump:  Not installed  
Manufacturer's name Pumpco  
Model number 10291520 HP 2 Volts 230  
Length of drop pipe 300 ft. capacity 16 g.m.p.  
Type:  
 Submersible  Turbine  
 Jet  Reciprocating  
 Centrifugal  Other

16 Remarks: elevation

Topography:  
 Hill  
 Slope  
 Upland  
 Valley

17 Water well contractor's certification:  
This well was drilled under my jurisdiction and this report is true to the best of my knowledge and belief.  
Steele Well Drilling 127  
Business name \_\_\_\_\_ License No. \_\_\_\_\_  
Address Hugoton Kansas 67951  
Signed Jim Steele Date 6-2-76  
Authorized representative

76  
14  
31  
38W  
19  
SESESE