


1 LOCATION OF WATER WELL: Fraction NW 1/4 NE 1/4 NE 1/4 Section Number 31 Township Number T 31 S Range Number R 38 E 11

Distance and direction from nearest town or city street address of well if located within city?  
 6N - 4 W- 1N-2W-1N-1W-1N-1W Hugoton, Ks. (9N. 7W)

2 WATER WELL OWNER: G. Dennis Schmidt  
 RR#, St. Address, Box # : N. Star Rt.  
 City, State, ZIP Code : Rolla, Kansas 67954  
 Board of Agriculture, Division of Water Resources  
 Application Number:

3 LOCATE WELL'S LOCATION WITH AN "X" IN SECTION BOX:

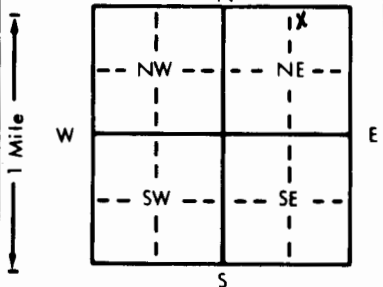

4 DEPTH OF COMPLETED WELL: 150 ft. ELEVATION:  
 Depth(s) Groundwater Encountered 1. .... ft. 2. .... ft. 3. .... ft.  
 WELL'S STATIC WATER LEVEL ... 40 ... ft. below land surface measured on mo/day/yr  
 Pump test data: Well water was .... ft. after .... hours pumping .... gpm  
 Est. Yield .... gpm: Well water was .... ft. after .... hours pumping .... gpm  
 Bore Hole Diameter ... 10 ... in. to ... 150 ... ft., and ... in. to ... ft.  
 WELL WATER TO BE USED AS: 5 Public water supply 8 Air conditioning 11 Injection well  
 ① Domestic 3 Feedlot 6 Oil field water supply 9 Dewatering ② Other (Specify below)  
 2 Irrigation 4 Industrial 7 Lawn and garden only 10 Observation well Stock  
 Was a chemical/bacteriological sample submitted to Department? Yes.....No XX.....; If yes, mo/day/yr sample was submitted  
 Water Well Disinfected? Yes XX No

5 TYPE OF BLANK CASING USED: 5 Wrought iron 8 Concrete tile CASING JOINTS: Glued XX Clamped XX  
 1 Steel 3 RMP (SR) 6 Asbestos-Cement 9 Other (specify below) Welded  
 ② PVC 4 ABS 7 Fiberglass Threaded

Blank casing diameter ... 5 ... in. to ... 130 ... ft., Dia ... in. to ... ft., Dia ... in. to ... ft.  
 Casing height above land surface ... 12-24 ... in., weight ... 200PSI ... lbs./ft. Wall thickness or gauge No. ... 262

TYPE OF SCREEN OR PERFORATION MATERIAL: 7 PVC 10 Asbestos-cement  
 1 Steel 3 Stainless steel 5 Fiberglass 8 RMP (SR) 11 Other (specify)  
 2 Brass 4 Galvanized steel 6 Concrete tile 9 ABS 12 None used (open hole)

SCREEN OR PERFORATION OPENINGS ARE: 5 Gauzed wrapped 8 Saw cut 11 None (open hole)  
 1 Continuous slot ③ Mill slot 6 Wire wrapped 9 Drilled holes  
 2 Louvered shutter 4 Key punched 7 Torch cut 10 Other (specify)

SCREEN-PERFORATED INTERVALS: From ... 130 ... ft. to ... 150 ... ft., From ... ft. to ... ft.  
 GRAVEL PACK INTERVALS: From ... 50 ... ft. to ... 150 ... ft., From ... ft. to ... ft.

6 GROUT MATERIAL: ① Neat cement 2 Cement grout 3 Bentonite 4 Other  
 Grout Intervals: From ... 0 ... ft. to ... 10 ... ft., From ... ft. to ... ft., From ... ft. to ... ft.

What is the nearest source of possible contamination: None  
 1 Septic tank 4 Lateral lines 7 Pit privy 10 Livestock pens 14 Abandoned water well  
 2 Sewer lines 5 Cess pool 8 Sewage lagoon 11 Fuel storage 15 Oil well/Gas well  
 3 Watertight sewer lines 6 Seepage pit 9 Feedyard 12 Fertilizer storage 16 Other (specify below)  
 13 Insecticide storage

Direction from well? How many feet?

FROM	TO	LITHOLOGIC LOG	FROM	TO	LITHOLOGIC LOG
0	80	Clay			
80	150	Sand W/ Clay Strips			

7 CONTRACTOR'S OR LANDOWNER'S CERTIFICATION: This water well was ① constructed, (2) reconstructed, or (3) plugged under my jurisdiction and was completed on (mo/day/year) ... 4/20/82 ... and this record is true to the best of my knowledge and belief. Kansas Water Well Contractor's License No. ... 160 ... This Water Well Record was completed on (mo/day/yr) ... 5/11/82 ... under the business name of JIM SMITH PUMP SERVICE by (signature) BK Betty Pearce

INSTRUCTIONS: Use typewriter or ball point pen, PLEASE PRESS FIRMLY and PRINT clearly. Please fill in blanks, underline or circle the correct answers. Send top three copies to Kansas Department of Health and Environment, Division of Environment, Environmental Geology Section, Topeka, KS 66620. Send one to WATER WELL OWNER and retain one for your records.

OFFICE USE ONLY T 31 R 38 E 11