


1 LOCATION OF WATER WELL: County: STEVENS Fraction: NE 1/4 NE 1/4 NE 1/4 Section Number: 25 Township Number: T 31 S Range Number: R 38 EW

Distance and direction from nearest town or city street address of well if located within city?
 8 MILES NORTH, 3 MILES WEST AND 500' SOUTH OF HUGOTON, KS.

2 WATER WELL OWNER: MAJORIE C. PERSINGER
 RR#, St. Address, Box #: 512 S. HARRISON Board of Agriculture, Division of Water Resources
 City, State, ZIP Code: HUGOTON, KS 67951 Application Number: 18,471

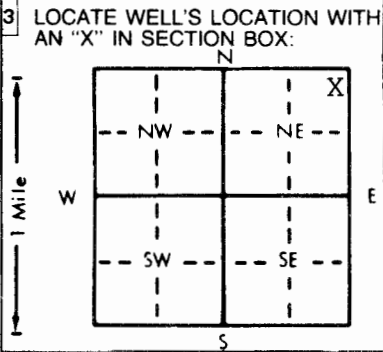

4 DEPTH OF COMPLETED WELL: 488 ft. ELEVATION: _____ ft.
 Depth(s) Groundwater Encountered 1. _____ ft. 2. _____ ft. 3. _____ ft.
 WELL'S STATIC WATER LEVEL: 223 ft. below land surface measured on mo/day/yr 5/17/94
 Pump test data: Well water was _____ ft. after _____ hours pumping _____ gpm
 Est. Yield _____ gpm: Well water was _____ ft. after _____ hours pumping _____ gpm
 Bore Hole Diameter: 26 in. to 488 ft., and _____ in. to _____ ft.
 WELL WATER TO BE USED AS:
 1 Domestic 3 Feedlot 6 Oil field water supply 9 Dewatering 12 Other (Specify below)
 2 Irrigation 4 Industrial 7 Lawn and garden only 10 Monitoring well
 Was a chemical/bacteriological sample submitted to Department? Yes _____ No X If yes, mo/day/yr sample was submitted _____
 Water Well Disinfected? Yes _____ No _____

5 TYPE OF BLANK CASING USED:
 Steel 3 RMP (SR) 5 Wrought iron 8 Concrete tile CASING JOINTS: Glued _____ Clamped _____
 PVC 4 ABS 6 Asbestos-Cement 9 Other (specify below) Welded X
 2 Brass 7 Fiberglass Threaded _____
 Blank casing diameter: 16 in. to 488 ft., Dia _____ in. to _____ ft., Dia _____ in. to _____ ft.
 Casing height above land surface: 12 in., weight 42.5 lbs./ft. Wall thickness or gauge No. 250
 TYPE OF SCREEN OR PERFORATION MATERIAL:
 Steel 3 Stainless steel 5 Fiberglass 8 RMP (SR) 10 Asbestos-cement
 Brass 4 Galvanized steel 6 Concrete tile 9 ABS 12 None used (open hole)
 SCREEN OR PERFORATION OPENINGS ARE:
 1 Continuous slot Mill slot 3 Mill slot 5 Gauzed wrapped 8 Saw cut 11 None (open hole)
 2 Louvered shutter 4 Key punched 6 Wire wrapped 9 Drilled holes
 7 Torch cut 10 Other (specify) _____
 SCREEN-PERFORATED INTERVALS: From PERF. 230 ft. to 290 ft., From SCREEN 290 ft. to 330 ft.
 From PERF. 330 ft. to 375 ft., From SCREEN 375 ft. to 415 ft.
 GRAVEL PACK INTERVALS: From 20 ft. to 488 ft., From PERF. 415 ft. to 460 ft.
 From SCREEN 460 ft. to 480 ft., From PERF. 480 ft. to 486 ft.

6 GROUT MATERIAL: Neat cement 2 Cement grout 3 Bentonite 4 Other _____
 Grout Intervals: From 0 ft. to 20 ft., From _____ ft. to _____ ft., From _____ ft. to _____ ft.
 What is the nearest source of possible contamination:
 1 Septic tank 4 Lateral lines 7 Pit privy 10 Livestock pens 14 Abandoned water well
 2 Sewer lines 5 Cess pool 8 Sewage lagoon 11 Fuel storage 15 Oil well/Gas well
 3 Watertight sewer lines 6 Seepage pit 9 Feedyard 12 Fertilizer storage 16 Other (specify below)
 CROPLAND - NOTHING IMMEDIATE VICINITY

FROM	TO	LITHOLOGIC LOG	FROM	TO	PLUGGING INTERVALS
0	220	SURFACE, SAND & CLAY			
220	260	MED. COARSE SAND			
260	420	FINE TO MED. SAND			
420	480	FINE SAND W/YELLOW CLAY STRINGERS			
480	500	RED & YELLOW CLAY			

7 CONTRACTOR'S OR LANDOWNER'S CERTIFICATION: This water well was (1) constructed, (2) reconstructed, or (3) plugged under my jurisdiction and was completed on (mo/day/year) 5/17/94 and this record is true to the best of my knowledge and belief. Kansas Water Well Contractor's License No. 225 This Water Well Record was completed on (mo/day/yr) 6/21/94 under the business name of KTM DRILLING, INC. by (signature) *Arnold Winter*