


USE TYPEWRITER OR BALL POINT PEN-PRESS FIRMLY, PRINT CLEARLY.

WATER WELL RECORD
KSA 82a-1201-1215

Kansas Department of Health and Environment-Division of Environment
(Water well Contractors)
Topeka, Kansas 66620

1. Location of well:	County Stevens	Fraction NW 1/4 NW 1/4 SE 1/4	Section number 3	Township number T 31 S R 39	Range number E 19
----------------------	--------------------------	---	----------------------------	---------------------------------------	-----------------------------

2. Distance and direction from nearest town or city: from Standard Service Station at Ulysses 11 miles south, Street address of well location if in city: 5 west, 2 south, 5 west 1/2 south	3. Owner of well: Vincent Youngreen R.R. or street: 1200 S. Monroe City, state, zip code: Hugoton, Ks. 67951
---	--

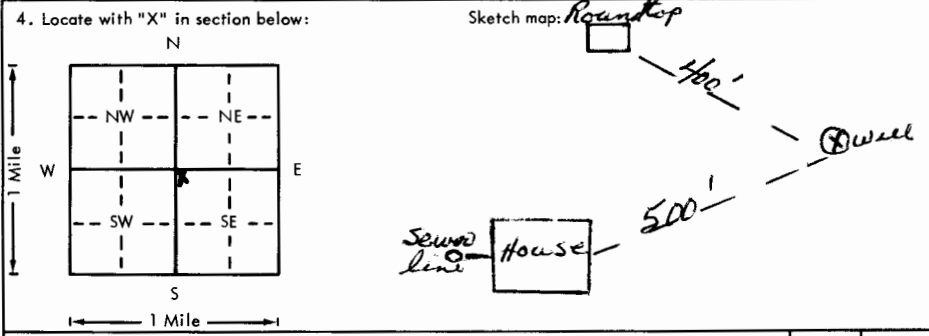

6. Bore hole dia. <u>9 1/2</u> in. Completion date _____ Well depth <u>320</u> ft. <u>9-7-77</u>
7. Cable tool <input checked="" type="checkbox"/> Rotary <input type="checkbox"/> Driven <input type="checkbox"/> Dug <input type="checkbox"/> Hollow rod <input type="checkbox"/> Jetted <input type="checkbox"/> Bored <input type="checkbox"/> Reverse rotary
8. Use: <input checked="" type="checkbox"/> Domestic <input type="checkbox"/> Public supply <input type="checkbox"/> Industry <input type="checkbox"/> Irrigation <input type="checkbox"/> Air conditioning <input type="checkbox"/> Stock <input type="checkbox"/> Lawn <input type="checkbox"/> Oil field water <input type="checkbox"/> Other
9. Casing: Material <u>styrene</u> Height <u>24</u> Above or below Threaded <u>Welded</u> Surface <u>24</u> in. RMP <u>PVC</u> Weight _____ lbs./ft. Dia. <u>5</u> in. to <u>220</u> ft. depth Wall Thickness: inches or Dia. _____ in. to _____ ft. depth Gage No. <u>320</u>

5. Type and color of material	From	To
Surface	0	2
Sandy clay	2	90
Fine sand	90	100
Sandy clay	100	130
Fine sand w/clay breakers	130	155
Fine to medium sand	155	188
Fine sand w/clay breakers	188	240
Sandy clay	240	265
Fine to medium sand	265	295
Fine sand w/clay strips	295	320

10. Screen: Manufacturer's name _____ Sunflower Type <u>styrene</u> Dia. <u>5"</u> Slot/gauze <u>1/16</u> Length <u>100'</u> Set between <u>220</u> ft. and <u>320</u> ft. <u>_____</u> ft. and <u>1/4</u> ft. Gravel pack? <input checked="" type="checkbox"/> Size range of material _____
11. Static water level: <u>146</u> ft. below land surface Date <u>7/29/77</u>
12. Pumping level below land surfaces: <u>160</u> ft. after <u>3</u> hrs. pumping <u>50</u> g.p.m. <u>_____</u> ft. after <u>_____</u> hrs. pumping <u>_____</u> g.p.m. Estimated maximum yield <u>_____</u> g.p.m.
13. Water sample submitted: _____ mo./day/yr. Yes <input type="checkbox"/> No <input checked="" type="checkbox"/> Date _____
14. Well head completion: <input checked="" type="checkbox"/> Pitless adapter <u>24</u> Inches above grade
15. Well grouted? <input checked="" type="checkbox"/> With: <input checked="" type="checkbox"/> Neat cement <input type="checkbox"/> Bentonite <input type="checkbox"/> Concrete Depth: From <u>0</u> ft. to <u>10</u> ft.
16. Nearest source of possible contamination: <u>100</u> ft. Direction <u>southwest</u> <u>Septic tank</u> Well disinfected upon completion? <input checked="" type="checkbox"/> Yes <input type="checkbox"/> No
17. Pump: <input checked="" type="checkbox"/> Not installed Manufacturer's name _____ Model number _____ HP _____ Volts _____ Length of drop pipe _____ ft. capacity _____ g.p.m. Type: <input type="checkbox"/> Submersible <input type="checkbox"/> Turbine <input type="checkbox"/> Jet <input type="checkbox"/> Reciprocating <input type="checkbox"/> Centrifugal <input type="checkbox"/> Other

18. Elevation:	19. Remarks:
Topography: <input type="checkbox"/> Hill <input checked="" type="checkbox"/> Slope <input type="checkbox"/> Upland <input type="checkbox"/> Valley	(Use a second sheet if needed)

20. Water well contractor's certification: This well was drilled under my jurisdiction and this report is true to the best of my knowledge and belief. Houck Bros. Drlg. Co. <u>164</u> Business name _____ License No. _____ Address Box 487, Ulysses, Ks. 67880 Signed <u>M. Beard</u> Date <u>9/7/77</u> Authorized representative

3 L 39 W E 3 NW W USE
 T R Sec 1/4 1/4 1/4