


1 LOCATION OF WATER WELL:	Fraction	Section Number	Township Number	Range Number
County: Stevens	C 1/4 NW 1/4 NW 1/4	14	T 31 S	R 39 E W

Distance and direction from nearest town or city street address of well if located within city?

14 $\frac{1}{4}$  miles NW of Feterita, KS--

2] WATER WELL OWNER:	OXY USA, Inc.	#1 MLP Denious-A
RR#, St. Address, Box # :	P.O. Box 26100	Board of Agriculture, Division of Water Resources
City, State, ZIP Code :	Oklahoma City, OK 73126-0100	Application Number: OXY permitted--

3 LOCATE WELL'S LOCATION WITH AN "X" IN SECTION BOX: 4 DEPTH OF COMPLETED WELL: 340 ft. ELEVATION: 150

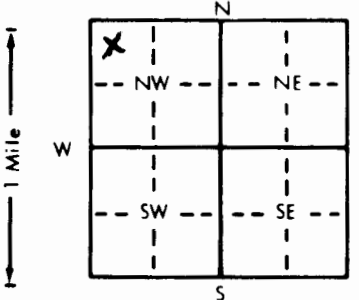

4 DEPTH OF COMPLETED WELL..... 340 ..... ft. ELEVATION: .....  
 Depth(s) Groundwater Encountered 1. .... 150 ..... ft. 2. .... ft. 3. .... ft.  
 WELL'S STATIC WATER LEVEL .... 150 ..... ft. below land surface measured on mo/day/yr ..... 02-14-91  
 Pump test data: Well water was .... 160 ..... ft. after .... 1 ..... hours pumping ..... 90 ..... gpm  
 Est. Yield .... 90 ..... gpm: Well water was ..... ft. after ..... hours pumping ..... gpm  
 Bore Hole Diameter .... 11 ..... in. to .... 340 ..... ft., and ..... in. to ..... ft.  
 WELL WATER TO BE USED AS: 5 Public water supply 8 Air conditioning 11 Injection well  
 1 Domestic 3 Feedlot 6 Oil field water supply 9 Dewatering 12 Other (Specify below)  
 2 Irrigation 4 Industrial 7 Lawn and garden only 10 Monitoring well .....  
 Was a chemical/bacteriological sample submitted to Department? Yes..... No..... ☒ ; If yes, mo/day/yr sample was submitted  
 Water Well Disinfected? Yes ☒ No

5 TYPE OF BLANK CASING USED: 5 Wrought iron 8 Concrete tile CASING JOINTS: Glued ☒ Clamped ☐  
1 Steel 3 RMP (SR) 6 Asbestos-Cement 9 Other (specify below) Welded ☐  
2 PVC 4 ABS 7 Fiberglass Threaded ☐  
Blank casing diameter 6 in. to 340 ft. Dia. in. to ft. Dia. in. to ft.  
Casing height above land surface 24 in. weight lbs./ft. Wall thickness or gauge No. .032

TYPE OF SCREEN OR PERFORATION MATERIAL:

1 Steel	3 Stainless steel	5 Fiberglass	7 PVC	10 Asbestos-cement
2 Brass	4 Galvanized steel	6 Concrete tile	8 RMP (SR)	11 Other (specify) .....
			9 ABS	12 None used (open hole)

SCREEN OR PERFORATION OPENINGS ARE:

1 Continuous slot	3 Mill slot	5 Gauzed wrapped	8 Saw cut	11 None (open hole)
2 Louvered shutter	4 Key punched	6 Wire wrapped	9 Drilled holes	
		7 Torch cut	10 Other (specify) .....	

SCREEN-PERFORATED INTERVALS:	From	300	ft. to	340	ft., From	ft. to	ft.
	From	220	ft. to	260	ft., From	ft. to	ft.
GRAVEL PACK INTERVALS:	From	140	ft. to	340	ft., From	ft. to	ft.
	From		ft. to		ft., From	ft. to	ft.

6 GROUT MATERIAL: 1 Neat cement 2 Cement grout 3 Bentonite 4 Other Hole plug

Grout Intervals: From 1 ft. to 20 ft. From ft. to ft. From ft. to ft.

What is the nearest source of possible contamination:

1 Septic tank	4 Lateral lines	7 Pit privy	10 Livestock pens	14 Abandoned water well
2 Sewer lines	5 Cess pool	8 Sewage lagoon	11 Fuel storage	15 Oil well/Gas well
3 Watertight sewer lines	6 Seepage pit	9 Feedyard	12 Fertilizer storage	16 Other (specify below)
13 Insecticide storage				

Direction from well? West

How many feet? 150

FROM	TO	LITHOLOGIC LOG	FROM	TO	PLUGGING INTERVALS
0	6	Top soil			
6	34	Sandy Clay			
34	48	White Clay			
48	129	Sandy Clay			
129	152	Sandy White Clay			
152	228	Sand and Gravel			
228	252	Sandy Clay			
252	289	Clay			
289	303	Gravel and Clay			
303	320	Sand			
320	330	Clay			
330	340	Gray Shale			

7. CONTRACTOR'S OR LANDOWNER'S CERTIFICATION: This water well was (1) constructed, (2) reconstructed, or (3) plugged under my jurisdiction and was completed on (mo/day/year) 02-14-91 and this record is true to the best of my knowledge and belief. Kansas Water Well Contractor's License No. KWWCL-430 This Water Well Record was completed on (mo/day/yr) 02-14-91 under the business name of Howard Drlg. Co. Box 806 Beaver, OK 73932 (signature) [Signature]