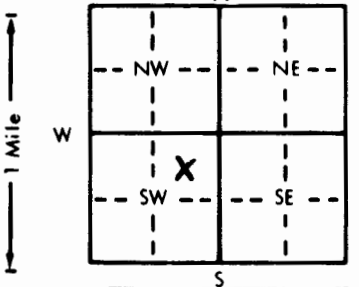


1 LOCATION OF WATER WELL:		Fraction	Section Number	Township Number	Range Number
County: Stevens		1/4 NE 1/4 SW 1/4	27	T 31 S	R 39 EW
Distance and direction from nearest town or city street address of well if located within city? 12 miles NW of Feterita, KS--					
2 WATER WELL OWNER:		Trans Pacific Oil Co.		#1-27 Swalar Co.	
RR#, St. Address, Box # :		1000 One Main Place		Board of Agriculture, Division of Water Resources	
City, State, ZIP Code :		Wichita, KS 67202		Application Number: 910462	
3 LOCATE WELL'S LOCATION WITH AN "X" IN SECTION BOX:		4 DEPTH OF COMPLETED WELL: 300 ft. ELEVATION:			
		Depth(s) Groundwater Encountered 1. 150 ft. 2. ft. 3. ft. WELL'S STATIC WATER LEVEL 150 ft. below land surface measured on mo/day/yr 10-13-91 Pump test data: Well water was 165 ft. after 1 hours pumping 90 gpm Est. Yield 90 gpm Well water was ft. after hours pumping gpm Bore Hole Diameter 9 1/2 in. to 300 ft. and in. to ft. WELL WATER TO BE USED AS: 1 Domestic 3 Feedlot 6 Oil field water supply 8 Air conditioning 11 Injection well 2 Irrigation 4 Industrial 7 Lawn and garden only 9 Dewatering 12 Other (Specify below) Was a chemical/bacteriological sample submitted to Department? Yes No X If yes, mo/day/yr sample was submitted Water Well Disinfected? Yes X No			
5 TYPE OF BLANK CASING USED:		5 Wrought iron 8 Concrete tile		CASING JOINTS: Glued X Clamped	
1 Steel 3 RMP (SR)		6 Asbestos-Cement 9 Other (specify below)		Welded	
2 PVC 4 ABS		7 Fiberglass		Threaded	
Blank casing diameter 5 in. to 300 ft. Dia in. to ft. Dia in. to ft.					
Casing height above land surface 24 in. weight lbs./ft. Wall thickness or gauge No. 032					
TYPE OF SCREEN OR PERFORATION MATERIAL:		7 PVC 10 Asbestos-cement			
1 Steel 3 Stainless steel 5 Fiberglass 8 RMP (SR) 11 Other (specify)					
2 Brass 4 Galvanized steel 6 Concrete tile 9 ABS 12 None used (open hole)					
SCREEN OR PERFORATION OPENINGS ARE:		5 Gauzed wrapped 8 Saw cut 11 None (open hole)			
1 Continuous slot 3 Mill slot 6 Wire wrapped 9 Drilled holes					
2 Louvered shutter 4 Key punched 7 Torch cut 10 Other (specify)					
SCREEN-PERFORATED INTERVALS: From 220 ft. to 300 ft. From ft. to ft. From ft. to ft. From ft. to ft.					
GRAVEL PACK INTERVALS: From 100 ft. to 300 ft. From ft. to ft. From ft. to ft. From ft. to ft.					
6 GROUT MATERIAL:		1 Neat cement 2 Cement grout 3 Bentonite 4 Other		Hole plug	
Grout Intervals: From 1 ft. to 20 ft. From ft. to ft. From ft. to ft. From ft. to ft.					
What is the nearest source of possible contamination:		10 Livestock pens 14 Abandoned water well			
1 Septic tank 4 Lateral lines 7 Pit privy 11 Fuel storage 15 Oil well/Gas well					
2 Sewer lines 5 Cess pool 8 Sewage lagoon 12 Fertilizer storage 16 Other (specify below)					
3 Watertight sewer lines 6 Seepage pit 9 Feedyard 13 Insecticide storage					
Direction from well? Northeast		How many feet? 175			
FROM	TO	LITHOLOGIC LOG	FROM	TO	PLUGGING INTERVALS
0	1	Surface			
1	21	Sandy Clay			
21	63	Clay			
63	74	Sandy Clay			
74	124	Clay			
124	135	Sand			
135	143	Clay			
143	224	Sand			
224	237	Clay			
237	275	Sand			
275	300	Blue Clay			
7 CONTRACTOR'S OR LANDOWNER'S CERTIFICATION: This water well was (1) constructed, (2) reconstructed, or (3) plugged under my jurisdiction and was completed on (mo/day/year) 10-13-91 and this record is true to the best of my knowledge and belief. Kansas Water Well Contractor's License No. KWWCL-430 This Water Well Record was completed on (mo/day/yr) 10-13-91 under the business name of Howard Drlg. Co. Box 806 Beaver, OK 73932 by (signature) Howard Swalar					
INSTRUCTIONS: Use typewriter or ball point pen. PLEASE PRESS FIRMLY and PRINT clearly. Please fill in blanks, underline or circle the correct answers. Send top three copies to Kansas Department of Health and Environment, Bureau of Water, Topeka, Kansas 66620-0001. Telephone: 913-296-5545. Send one to WATER WELL OWNER and retain one for your records.					