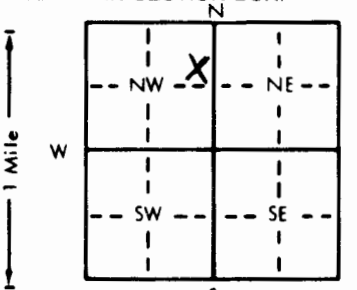


1 LOCATION OF WATER WELL: County: MORTON	Fraction SE 1/4 NE 1/4 NW 1/4	Section Number 33	Township Number T 31S S	Range Number R 39W E/W
--	---	-----------------------------	-----------------------------------	----------------------------------

Distance and direction from nearest town or city street address of well if located within city?

14 MILES NORTHWEST OF HUGOTON.

2 WATER WELL OWNER: OKY USA. RR#, St. Address, Box # : P.O. BOX 26100 City, State, ZIP Code : OKLAHOMA CITY, OK 73126 -0100	Hazen A-1 Board of Agriculture, Division of Water Resources Application Number: 950118
--	--

3 LOCATE WELL'S LOCATION WITH AN "X" IN SECTION BOX: 	4 DEPTH OF COMPLETED WELL: 320 ft. ELEVATION: Depth(s) Groundwater Encountered 1. 170 ft. 2. ft. 3. ft. WELL'S STATIC WATER LEVEL 170 ft. below land surface measured on mo/day/yr 4-17-95 Pump test data: Well water was 190 ft. after 1 hours pumping 100 gpm Est. Yield 100 gpm: Well water was ft. after hours pumping gpm Bore Hole Diameter 11 in. to 320 ft. and in. to ft. WELL WATER TO BE USED AS: 1 Domestic 3 Feedlot 5 Public water supply 8 Air conditioning 11 Injection well 2 Irrigation 4 Industrial 6 Oil field water supply 9 Dewatering 12 Other (Specify below) 7 Lawn and garden only 10 Monitoring well Was a chemical/bacteriological sample submitted to Department? Yes No X If yes, mo/day/yr sample was submitted Water Well Disinfected? Yes X No
--	--

5 TYPE OF CASING USED: 1 Steel 3 RMP (SR) 5 Wrought iron 8 Concrete tile 2 PVC 4 ABS 6 Asbestos-Cement 9 Other (specify below) Blank casing diameter 6 in. to 320 ft. Dia. in. to ft. Dia. in. to ft. Casing height above land surface 24 in. weight 2.902 lbs./ft. Wall thickness or gauge No. 280 SDR 21 TYPE OF SCREEN OR PERFORATION MATERIAL: 1 Steel 3 Stainless steel 5 Fiberglass 8 RMP (SR) 10 Asbestos-cement 2 Brass 4 Galvanized steel 6 Concrete tile 9 ABS 11 Other (specify) 12 None used (open hole) SCREEN OR PERFORATION OPENINGS ARE: 1 Continuous slot 3 Mill slot 5 Gauzed wrapped 8 Saw cut 11 None (open hole) 2 Louvered shutter 4 Key punched 6 Wire wrapped 9 Drilled holes 7 Torch cut 10 Other (specify) SCREEN-PERFORATED INTERVALS: From 240 ft. to 320 ft. From ft. to ft. GRAVEL PACK INTERVALS: From 220 ft. to 320 ft. From ft. to ft. From ft. to ft. From ft. to ft.

6 GROUT MATERIAL: 1 Neat cement 2 Cement grout 3 Bentonite 4 Other HOLE PLUG Grout Intervals: From 20 ft. to ft. From ft. to ft. From ft. to ft. What is the nearest source of possible contamination: 1 Septic tank 4 Lateral lines 7 Pit privy 10 Livestock pens 14 Abandoned water well 2 Sewer lines 5 Cess pool 8 Sewage lagoon 11 Fuel storage 15 Oil well/Gas well 3 Watertight sewer lines 6 Seepage pit 9 Feedyard 12 Fertilizer storage 16 Other (specify below) 13 Insecticide storage Direction from well? East How many feet? 150

FROM	TO	LITHOLOGIC LOG	FROM	TO	PLUGGING INTERVALS
0	2	CLAY TOP			
2	67	CLAY			
67	72	SANDY CLAY			
72	101	CLAY			
101	168	SANDY CLAY			
168	235	SANDY CLAY			
235	243	CLAY			
243	260	SAND & SANDY CLAY			
260	273	FINE RED SAND			
273	300	WHITE SAND			
300	320	YELLOW, RED, & BLACK CLAY			

7 CONTRACTOR'S OR LANDOWNER'S CERTIFICATION: This water well was (1) constructed, (2) reconstructed, or (3) plugged under my jurisdiction and was completed on (mo/day/year) 4-17-95 and this record is true to the best of my knowledge and belief. Kansas Water Well Contractor's License No. KWCL-430 This Water Well Record was completed on (mo/day/yr) 4-17-95 under the business name of HOWARD DRUG CO. BOX 806 BEAVER, OK 73932 by (signature) <i>[Signature]</i>
--

INSTRUCTIONS: Use typewriter or ball point pen. PLEASE PRESS FIRMLY and PRINT clearly. Please fill in blanks, underline or circle the correct answers. Send top three copies to Kansas Department of Health and Environment, Bureau of Water, Topeka, Kansas 66620-0001. Telephone: 913-296-5545. Send one to WATER WELL OWNER and retain one for your records.