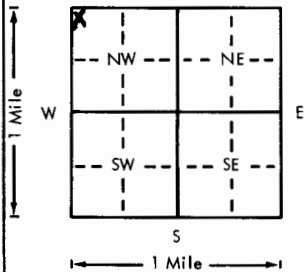


USE TYPEWRITER OR BALL  
POINT PEN-PRESS FIRMLY,  
PRINT CLEARLY.

WATER WELL RECORD  
KSA 82a-1201-1215

Kansas Department of Health and  
Environment-Division of Environment  
(Water well Contractors)  
Topeka, Kansas 66620

1. Location of well:		County <b>Sumner</b>	Fraction <b>1/4 NW 1/4 NW 1/4</b>	Section number <b>14</b>	Township number <b>T 31 S</b>	Range number <b>R 4W E/W</b>
2. Distance and direction from nearest town or city: Street address of well location if in city: <b>4 West of Conway Springs, 2 1/4 South of the</b>				3. Owner of well: <b>Cletus Zoglmann</b> R. R. or street: <b>R. R. #2</b> City, state, zip code: <b>Conway, Springs, Kansas</b>		
4. Locate with "X" in section below: Sketch map: 				6. Bore hole dia. <b>11</b> in. Completion date <b>7-9-77</b> Well depth <b>75</b> ft.		
5. Type and color of material				7. <input checked="" type="checkbox"/> Cable tool <input checked="" type="checkbox"/> Rotary <input type="checkbox"/> Driven <input type="checkbox"/> Dug <input type="checkbox"/> Hollow rod <input type="checkbox"/> Jetted <input type="checkbox"/> Bored <input type="checkbox"/> Reverse rotary		
				8. Use: <input checked="" type="checkbox"/> Domestic <input type="checkbox"/> Public supply <input type="checkbox"/> Industry <input type="checkbox"/> Irrigation <input type="checkbox"/> Air conditioning <input type="checkbox"/> Stock <input type="checkbox"/> Lawn <input type="checkbox"/> Oil field water <input type="checkbox"/> Other		
				9. Casing: Material <b>styrene</b> Height: Above or below <b>111</b> Threaded <input type="checkbox"/> Welded <b>g1</b> Surface <b>12</b> in. RMP <input checked="" type="checkbox"/> PVC <input type="checkbox"/> Weight <b>111</b> lbs./ft. Dia. <b>5</b> in. to <b>75</b> ft. depth Wall Thickness: inches or Dia. <b>1</b> in. to <b>75</b> ft. depth gage No. <b>200</b>		
				10. Screen: Manufacturer's name <b>Sunflower Plastic</b> Type <b>styrene</b> Dia. <b>5</b> " Slot/gauge <b>.06</b> Length <b>57</b> Set between <b>18</b> ft. and <b>75</b> ft. ft. and <b>75</b> ft. Gravel pack? <b>yes</b> Size range of material <b>1/4-1/8"</b>		
				11. Static water level: <b>15</b> ft. below land surface Date <b>7-9-77</b> mo./day/yr.		
(Use a second sheet if needed)				12. Pumping level below land surfaces: ft. after hrs. pumping g.p.m. ft. after hrs. pumping g.p.m. Estimated maximum yield g.p.m.		
				13. Water sample submitted: <b>15</b> mo./day/yr. Yes No Date		
				14. Well head completion: <b>12</b> capped Pitless adapter <b>12</b> inches above grade		
				15. Well grouted? <b>yes</b> <b>1-2</b> fine sand mix With: Neat cement Bentonite <input checked="" type="checkbox"/> Concrete Depth: From <b>40</b> ft. to <b>14</b> ft.		
				16. Nearest source of possible contamination: <b>350</b> <b>East</b> <b>Septic Tank</b> ft. Direction Type Well disinfected upon completion? <input checked="" type="checkbox"/> Yes No		
(Use a second sheet if needed)				17. Pump: <input checked="" type="checkbox"/> Not installed Manufacturer's name Model number HP Volts Length of drop pipe ft. capacity g.p.m. Type: <input type="checkbox"/> Submersible <input type="checkbox"/> Turbine <input type="checkbox"/> Jet <input type="checkbox"/> Reciprocating <input type="checkbox"/> Centrifugal <input type="checkbox"/> Other		
				18. Elevation:		
				19. Remarks:		
				20. Water well contractor's certification: This well was drilled under my jurisdiction and this report is true to the best of my knowledge and belief. <b>Harp Well &amp; Pump Serv. 236</b> Business name License No. Address <b>Wichita, Kansas 67209</b> Signed <b>M. Arnold</b> Date <b>11-21-77</b> Authorized representative		
				Topography: <input checked="" type="checkbox"/> Hill <input type="checkbox"/> Slope <input type="checkbox"/> Upland <input type="checkbox"/> Valley		

Forward the white, blue and pink copies to the Department of Health and Environment

Form WWC-5