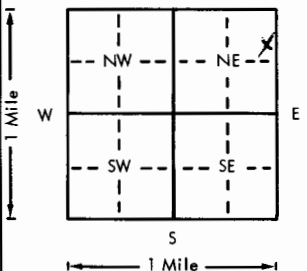


USE TYPEWRITER OR BALL
POINT PEN-PRESS FIRMLY,
PRINT CLEARLY.

WATER WELL RECORD
KSA 82a-1201-1215

Kansas Department of Health and
Environment-Division of Environment
(Water well Contractors)
Topeka, Kansas 66620

1. Location of well: County <u>Sumner</u> <u>NE</u> 1/4 <u>NE</u> 1/4 <u>NE</u> 1/4 Section number <u>24</u> Township number <u>T 31</u> S <u>R 4</u> E/W <u>E/W</u>	
2. Distance and direction from nearest town or city: <u>3-5, 3W-1/2-S</u> Street address of well location if in city: <u>Canway Springs, Ks</u>	
3. Owner of well: <u>Jack Wilson</u> R.R. or street: <u>8201 Vesta Ave.</u> City, state, zip code: <u>Wichita Kansas 67233</u>	
4. Locate with "X" in section below: Sketch map: <u>New Const. & location</u>	
	
5. Type and color of material	
6. Bore hole dia. <u>2 1/4</u> in. Completion date <u>1-10-78</u> Well depth <u>50</u> ft.	
7. <input checked="" type="checkbox"/> Cable tool <input type="checkbox"/> Rotary <input type="checkbox"/> Driven <input type="checkbox"/> Dug <input type="checkbox"/> Hollow rod <input type="checkbox"/> Jetted <input type="checkbox"/> Bored <input type="checkbox"/> Reverse rotary	
8. Use: <input checked="" type="checkbox"/> Domestic <input type="checkbox"/> Public supply <input type="checkbox"/> Industry <input type="checkbox"/> Irrigation <input type="checkbox"/> Air conditioning <input type="checkbox"/> Stock <input type="checkbox"/> Lawn <input type="checkbox"/> Oil field water <input type="checkbox"/> Other	
9. Casing: Material <u>Pls</u> Height: <u>Above</u> or below Threaded <input type="checkbox"/> Welded <input type="checkbox"/> Surface <u>11</u> in. RMP <input checked="" type="checkbox"/> PVC <input type="checkbox"/> Weight <u>18</u> lbs./ft. Dia. <u>6</u> in. to <u>38</u> ft. depth Wall Thickness: <u>inches</u> or Dia. <u>6</u> in. to <u>38</u> ft. depth Gauge No. <u>18</u>	
10. Screen: Manufacturer's name <u>Sunflower Plastic Pipe</u> Type <u>RMP</u> Dia. <u>6"</u> Slot/gauze <u>06/16</u> Length <u>12'</u> Set between <u>38</u> ft. and <u>50</u> ft. Gravel pack? <input checked="" type="checkbox"/> Size range of material <u>1/16 - 1/8</u>	
11. Static water level: <u>26</u> ft. below land surface Date <u>1-15-78</u>	
12. Pumping level below land surfaces: <u>Not Pumped</u> ____ ft. after ____ hrs. pumping ____ g.p.m. ____ ft. after ____ hrs. pumping ____ g.p.m. Estimated maximum yield ____ g.p.m.	
13. Water sample submitted: ____ mo./day/yr. Yes <input checked="" type="checkbox"/> No <input type="checkbox"/> Date ____	
14. Well head completion: <u>30</u> ____ Pitless adapter ____ Inches above grade	
15. Well grouted? <input checked="" type="checkbox"/> With: ____ Neat cement ____ Bentonite <input checked="" type="checkbox"/> Concrete Depth: From <u>10</u> ft. to <u>top</u> ft.	
16. Nearest source of possible contamination: ft. <u>350</u> Direction <u>NW</u> Type <u>Brow</u> Well disinfected upon completion? <input checked="" type="checkbox"/> Yes <input type="checkbox"/> No	
17. Pump: <input checked="" type="checkbox"/> Not installed Manufacturer's name ____ Model number ____ HP ____ Volts ____ Length of drop pipe ____ ft. capacity ____ g.p.m. Type: ____ Submersible ____ Turbine ____ Jet ____ Reciprocating ____ Centrifugal ____ Other	
18. Elevation: Topography: <input type="checkbox"/> Hill <input checked="" type="checkbox"/> Slope <input type="checkbox"/> Upland <input type="checkbox"/> Valley	
19. Remarks: <u>Winter Const Co 352</u> Business name <u>216 N Canway</u> License No. ____ Address <u>Englewood</u> Date <u>1-10-78</u> Signed <u>Englewood</u> Authorized representative	

Forward the white, blue and pink copies to the Department of Health and Environment

Form WWC-5