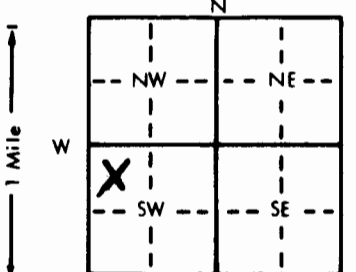


1 LOCATION OF WATER WELL:	Fraction	Section Number	Township Number	Range Number
County: MORTON	C ¼ NW ¼ SW ¼	10	T 31S S	R 40W E

Distance and direction from nearest town or city street address of well if located within city?

9 MILES NORTH EAST RICHFIELD, KS.

2 WATER WELL OWNER: CHARTER PRODUCTION CO.	#1 BREWSTER TRUST
RR#, St. Address, Box #: 224 E. DOUGLAS, #400	Board of Agriculture, Division of Water Resources
City, State, ZIP Code: WICHITA, KS 67202	Application Number: 940037

3 LOCATE WELL'S LOCATION WITH AN "X" IN SECTION BOX:	4 DEPTH OF COMPLETED WELL: 420 ft. ELEVATION:
	Depth(s) Groundwater Encountered 1. 185 ft. 2. ft. 3. ft.
	WELL'S STATIC WATER LEVEL 185 ft. below land surface measured on mo/day/yr 1-28-94
	Pump test data: Well water was 205 ft. after 1 hours pumping 90 gpm
	Est. Yield 90 gpm: Well water was ft. after hours pumping gpm
	Bore Hole Diameter 11 in. to 420 ft. and in. to ft.
	WELL WATER TO BE USED AS:
	1 Domestic 3 Feedlot 6 Oil field water supply 8 Air conditioning 11 Injection well
	2 Irrigation 4 Industrial 7 Lawn and garden only 9 Dewatering 12 Other (Specify below)
	Was a chemical/bacteriological sample submitted to Department? Yes No x; If yes, mo/day/yr sample was submitted
	Water Well Disinfected? Yes x No

5 TYPE OF BLANK CASING USED:	5 Wrought iron 8 Concrete tile CASING JOINTS: Glued x Clamped
1 Steel 3 RMP (SR) 6 Asbestos-Cement 9 Other (specify below) Welded	
2 PVC 4 ABS 7 Fiberglass Threaded	
Blank casing diameter 6 in. to 420 ft. Dia in. to ft. Dia in. to ft.	
Casing height above land surface 24 in. weight 2.902 lbs./ft. Wall thickness or gauge No. 316 SDR 21	
TYPE OF SCREEN OR PERFORATION MATERIAL:	7 PVC 10 Asbestos-cement
1 Steel 3 Stainless steel 5 Fiberglass 8 RMP (SR) 11 Other (specify)	
2 Brass 4 Galvanized steel 6 Concrete tile 9 ABS 12 None used (open hole)	
SCREEN OR PERFORATION OPENINGS ARE:	8 Saw cut 11 None (open hole)
1 Continuous slot 3 Mill slot 6 Wire wrapped 9 Drilled holes	
2 Louvered shutter 4 Key punched 7 Torch cut 10 Other (specify)	
SCREEN-PERFORATED INTERVALS: From 320 ft. to 420 ft. From ft. to ft.	
GRAVEL PACK INTERVALS: From 120 ft. to 420 ft. From ft. to ft.	

6 GROUT MATERIAL:	1 Neat cement 2 Cement grout 3 Bentonite 4 Other HOLE PLUG
Grout intervals: From 1 ft. to 20 ft. From ft. to ft. From ft. to ft.	
What is the nearest source of possible contamination:	10 Livestock pens 14 Abandoned water well
1 Septic tank 4 Lateral lines 7 Pit privy 11 Fuel storage 15 Oil well/Gas well	
2 Sewer lines 5 Cess pool 8 Sewage lagoon 12 Fertilizer storage 16 Other (specify below)	
3 Watertight sewer lines 6 Seepage pit 9 Feedyard 13 Insecticide storage	
Direction from well? SOUTH EAST	How many feet? 200

FROM	TO	LITHOLOGIC LOG	FROM	TO	PLUGGING INTERVALS
0	2	TOP SOIL			
2	43	CLAY			
43	84	FINE SAND			
84	144	SANDY CLAY			
144	230	SAND & GRAVEL			
230	346	BLACK CLAY			
346	380	BROWN CLAY			
380	393	FINE SAND			
393	400	CLAY OF STREAKS OF SAND			
400	406	CLAY			
406	415	FINE SAND			
415	420	CLAY			

7 CONTRACTOR'S OR LANDOWNER'S CERTIFICATION: This water well was (1) constructed, (2) reconstructed, or (3) plugged under my jurisdiction and was completed on (mo/day/year) 1-28-94 and this record is true to the best of my knowledge and belief. Kansas
Water Well Contractor's License No. KWWCL-430 This Water Well Record was completed on (mo/day/year) 1-28-94
under the business name of HOWARD DRLG.CO. BOX 806 BEAVER, OK 73932 by (signature) Howard DRLG

INSTRUCTIONS: Use typewriter or ball point pen. PLEASE PRESS FIRMLY and PRINT clearly. Please fill in blanks, underline or circle the correct answers. Send top three copies to Kansas Department of Health and Environment, Bureau of Water, Topeka, Kansas 66620-0001. Telephone: 913-296-5545. Send one to WATER WELL OWNER and retain one for your records.

17951