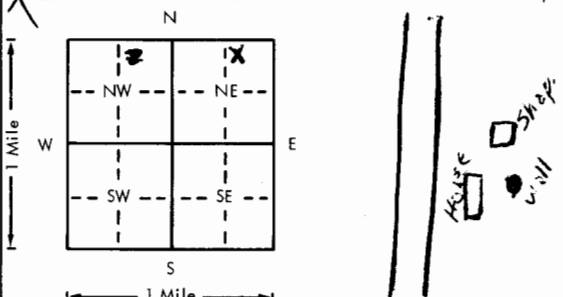


USE TYPEWRITER OR
POINT PEN-PRESS
PRINT CLEARLY.

WATER WELL RECORD
KSA 82a-1201-1215

Kansas Department of Health and
Environment-Division of Environment
(Water well Contractors)
Topeka, Kansas 66620

1. Name of well:		County: <u>Morton</u>	Tract: <u>NE 1/4 NE 1/4 NE 1/4</u>	Section number: <u>17</u>	Township number: <u>31 S</u>	Range number: <u>40 E</u>
2. Distance and direction from nearest town or city: <u>18 mi S - 3 mi E - 1/4 North of Johnson, Mo.</u>				3. Owner of well: <u>Wayne Breeding</u> R.R. or street: City, state, zip code: <u>Rolla, Kansas 67954</u>		
X. Locate with "X" in section below:		Sketch map:		6. Bore hole dia. <u>9</u> in. Completion date <u>8/79</u> Well depth <u>275</u> ft.		
				7. Cable tool <input checked="" type="checkbox"/> Rotary <input type="checkbox"/> Driven <input type="checkbox"/> Dug <input type="checkbox"/> Hollow rod <input type="checkbox"/> Jetted <input type="checkbox"/> Bored <input type="checkbox"/> Reverse rotary		
5. Type and color of material		From	To	X. Use: <input checked="" type="checkbox"/> Domestic <input checked="" type="checkbox"/> Public supply <input type="checkbox"/> Industry <input type="checkbox"/> Irrigation <input type="checkbox"/> Air conditioning <input type="checkbox"/> Stock <input type="checkbox"/> Lawn <input type="checkbox"/> Oil field water <input type="checkbox"/> Other		
<u>CLAY</u>		<u>0</u>	<u>40'</u>	9. Casing: Material <input type="checkbox"/> Height: Above or below Threaded <input type="checkbox"/> Welded <input type="checkbox"/> Surface <input type="checkbox"/> in. RMP <input type="checkbox"/> PVC <input checked="" type="checkbox"/> Weight <u>200</u> lbs./ft. Dia. <u>3</u> in. to <u>10</u> ft. depth Wall thickness: inches or Dia. <u>3</u> in. to <u>10</u> ft. depth gage No. <u>300251</u>		
<u>SAND</u>		<u>40'</u>	<u>170'</u>	10. Screen: Manufacturer's name <u>Getstream</u> Type <u>PVC</u> Dia. <u>3"</u> Slot/gauze <input checked="" type="checkbox"/> Length <u>40'</u> Set between <u>235'</u> ft. and <u>275'</u> ft. ft. and ft. Gravel pack? <input checked="" type="checkbox"/> Size range of material <u>#1</u>		
<u>Shell Blue</u>		<u>170'</u>	<u>225'</u>	11. Static water level: <u>140'</u> ft. below land surface Date <u>8/79</u> mg./day/yr.		
<u>Sandstone</u>		<u>225'</u>	<u>275'</u>	12. Pumping level below land surfaces: <u>160'</u> ft. after <u>12</u> hrs. pumping <u>12</u> g.p.m. ft. after hrs. pumping g.p.m. Estimated maximum yield g.p.m.		
				13. Water sample submitted: <u>Yes</u> <input checked="" type="checkbox"/> No <input type="checkbox"/> Date		
				14. Well head completion: <input checked="" type="checkbox"/> Pitless adapter <u>24"</u> inches above grade		
				X. Well grouted? <input type="checkbox"/> With: <input type="checkbox"/> Neat cement <input checked="" type="checkbox"/> Bentonite <input checked="" type="checkbox"/> Concrete Depth: From <u>6</u> ft. to <u>20</u> ft.		
				X. Nearest source of possible contamination: ft. <u>100</u> Direction <u>NE</u> Type <u>Stream</u> Well disinfected upon completion? <input checked="" type="checkbox"/> Yes <input type="checkbox"/> No		
				17. Pump: <input type="checkbox"/> Not installed Manufacturer's name <u>Cent</u> Model number <u>CE 15</u> HP <u>1/2</u> Volts <u>115</u> Length of drop pipe <u>210'</u> ft. capacity <u>12</u> g.p.m. Type: <input checked="" type="checkbox"/> Submersible <input type="checkbox"/> Turbine <input type="checkbox"/> Jet <input type="checkbox"/> Reciprocating <input type="checkbox"/> Centrifugal <input type="checkbox"/> Other		
18. Elevation:		19. Remarks:		20. Water well contractor's certification: This well was drilled under my jurisdiction and this report is true to the best of my knowledge and belief. <u>160</u> <u>Jim Smith Pump Service</u> Business name License No. <u>67855</u> Address <u>Johnson, Mo.</u> Signed <u>James R. Smith</u> Date <u>8/79</u> Authorized representative		

31 400 17 NE NE NE
1/4 1/4 1/4