USE TYPEWRITER OR BALL POINT PEN-PRESS FIRMLY, PRINT CLEARLY.

T	R	EW	sec	1/4	1/4	1/4	No.

WATER WELL RECORD
KSA 82a-1201-1215

Kansas State Dept. Of Health
(Water Well Contractors)
Forbes-Bldg. 740
Topeka, Kansas 66620

1 Location of well:	County	Township name	Fraction	Section number	Town number	Range number
	MORTON	Westola	SE/4 SE/4 NE/4	29	Westola 31 (S)	43 (W)

Distance and direction from nearest town or city: 15 S 4 W MANTER-KANS

Street address of well location if in city:

3 Owner of well: JOHNNIE TRAHERN
Address: STAR Route WALSH-Colo 81090

Locate with "X" in section below:

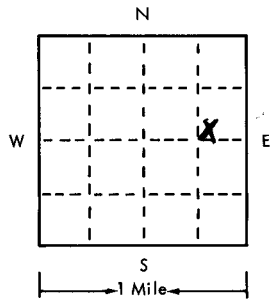

Sketch map:

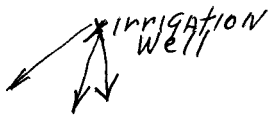

4 Well depth: 100 ft. Date of completion July 25-76
Well diameter 18 in.

5 ☐ Cable tool ☒ Rotary ☐ Driven ☐ Dug ☐ Hollow rod ☐ Jetted ☐ Bored ☐ Reverse rotary

6 Use: ☐ Domestic ☐ Public supply ☐ Industry ☒ Irrigation ☐ Air conditioning ☐ Commercial ☐ Test well ☐

7 Casing: Material Steel Height: above/below
Threaded ☐ Welded ☐ Surface 18 in. → 36.91#
Diam. 16" Weight 219 lbs./ft.
Drive shoe? ☐ Yes ☒ No
0 in. to 43 ft. depth
Hole 14 in. to 100 ft. depth

2 Type and color of material	From	To
Topsoil	0	8
Clay - Brown & Sandy	8	41
Rock - HARD Mulpible Colars	41	58
Sandrock - Tan & Red	58	80
Sandrock White Silty	80	95
Shale - Black	95	100
(use a second sheet if needed)		

~~Screen:~~
Manufacturer Kaiser Steel Co
Type Steel Dia. 16"
Slot/gauze ____ Length 42'
Set between ____ ft. and ____ ft.
Fittings:
Gravel pack ☒ Yes ☐ No Size range of material 3/4

9 Static water level:
49 ft. below land surface Date July 25-76

10 Pumping level below land surfaces:
75 ft. after 5 hrs. pumping 550 g.p.m.
75 ft. after 12 hrs. pumping 550 g.p.m.
Estimated maximum yield 550 g.p.m.

11 Water sample submitted:
☐ Yes ☒ No Date ____

12 Well head completion: 18"
☐ Pitless adapter ☒ Inches above grade

13 Well grouted? ☐ Yes ☒ No
☒ Neat cement ☐ Bentonite ☐ ____
Depth: From 0 ft. to 10 ft.

14 Nearest source of possible contamination: None
ft. ____ Direction ____ Type ____
Well disinfected upon completion? ☐ Yes ☐ No

15 Pump: ☐ Not installed
Manufacturer's name Western Pump Co
Model number 14266 HP 85 Volts ____
Length of drop pipe 80 ft. capacity 600 g.m.p.
Type:
☐ Submersible ☒ Turbine
☐ Jet ☐ Reciprocating
☐ Certrifugal ☐ Other

16 Remarks: elevation
Concrete Slab To Installed By Land Owner 18" Above Ground

Topography:
☐ Hill
☒ Slope
☐ Upland
☐ Valley

17 Water well contractor's certification:
This well was drilled under my jurisdiction and this report is true to the best of my knowledge and belief.
Ralph's Irrigation Drilling Co Inc
Business name License No. 154
Address 1300 So. Main
Signed Ralph Richards Date Aug 5-76
Authorized representative

31 43W 29 SESENE

Forward the white, blue and pink copies to the Kansas State Dept. Of Health.

Form WWC-5