


WATER WELL RECORD Form WWC-5 KSA 82a-1212

1 LOCATION OF WATER WELL: Fraction Section Number Township Number Range Number
 COUNTY: MORTON NE 1/4 NE 1/4 SW 1/4 16 T 31 S R 43 W

Distance and direction from nearest town or city street address of well if located within city?
 MANTER S ON BLACKTOP - 10M W/ON COUNTY LINE RD.5-3S-1W & 1/2N

2 WATER WELL OWNER: SIPES LAND & CATTLE
 RR#, St. Address, Box #: 12900 S RD. Board of Agriculture, Division of Water Resources
 City, State, ZIP code: MANTER, KS 67862- Application Number:

3 LOCATE WELL'S LOCATION WITH AN "X" IN SECTION BOX:

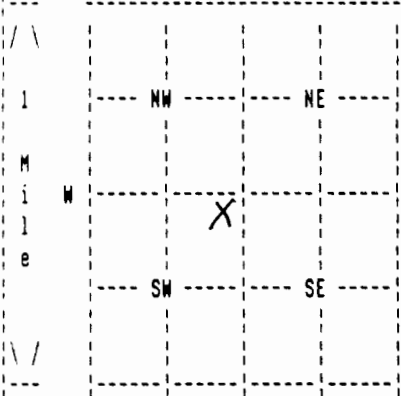

4 DEPTH OF COMPLETED WELL 125 ELEVATION: 0
 Depth(s) Groundwater Encountered 1. 0 ft. 2. 0 ft. 3. 0 ft.

WELL'S STATIC WATER LEVEL 53 ft. below land surface measured on mo/day/yr 08/05/10
 Pump test data: Well water was 0 ft. after 0 hours pumping 0 gpm

Estimated Yield 30 gpm: Well water was 0 ft. after 0 hours pumping 0 gpm

Bore Hole Diameter 9 in. to 125 ft., and in. to 0 ft.

WELL WATER TO BE USED AS: DOMESTIC

Was a chemical/bacteriological sample submitted to department? No ;
 If yes, mo/day/yr sample was submitted Water well disinfected? Yes

5 TYPE OF BLANK CASING USED: CERTA LOC CASIN CASING JOINTS: CERTA-LOC
 Blank casing diameter 5 in. to 125 ft., Dia in. to 0 ft., Dia in. to 0 ft.
 Casing height above land surface 12 in., weight 200 lbs/ft. Wall thickness or gauge No. 21
 TYPE OF SCREEN OR PERFORATION MATERIAL: PVC
 SCREEN OR PERFORATION OPENINGS ARE: SAW CUT

SCREEN PERFORATED INTERVALS: From 80 ft. to 120 ft., From 0 ft. to 0 ft.
 From 0 ft. to 0 ft., From 0 ft. to 0 ft.
 GRAVEL PACK INTERVALS: From 25 ft. to 125 ft., From 0 ft. to 0 ft.
 From 0 ft. to 0 ft., From 0 ft. to 0 ft.

6 GROUT MATERIAL BENTONITE
 Grout Intervals: From 5 ft. to 25 ft., From 0 ft. to 0 ft., From 0 ft. to 0 ft.
 What is the nearest source of possible contamination: ABANDONED WELL
 Direction from well? SOUTHEAST How many feet? 20

FROM	TO	LITHOLOGIC LOG	FROM	TO	PLUGGING INTERVALS
0	20	01 TOPSOIL 05 CLAY			
20	40	05 CLAY 24 THINROCLAYER 02 FINE SAND			
40	60	02 FINE SAND 41 RED SANDSTON 40 TAN SANDSTON			
60	70	40 TAN SANDSTON			
70	80	27 ROCK 18 LARGE			
80	130	29 SANDSTONE			
130	0	07 BLUE SHALE			

7 CONTRACTOR'S OR LANDOWNER'S CERTIFICATION: This water well was Constructed under my jurisdiction and was completed on (mo/day/year) 08/06/10 and this record is true to the best of my knowledge and belief. Kansas Water Well Contractor's License No. 179 This Water Well Record was completed on (mo/day/yr) 08/10/10 under the business name of JOE'S WELL SERVICE, INC. by (signature) *Judith Crial*