


1 LOCATION OF WATER WELL: County: Harper Fraction: NW 1/4 NW 1/4 NE 1/4 Section Number: 34 Township Number: T 31 S Range Number: R 5 E **(W)**

Distance and direction from nearest town or city street address of well if located within city?
Approximately 2 1/2 miles east and 2 miles north of Danville

2 WATER WELL OWNER: Randy L. and Debra L. Blanchat
RR#, St. Address, Box #: 847 Northeast 90th Avenue Board of Agriculture, Division of Water Resources
City, State, ZIP Code: Danville, KS 67036 Application Number: 46,009

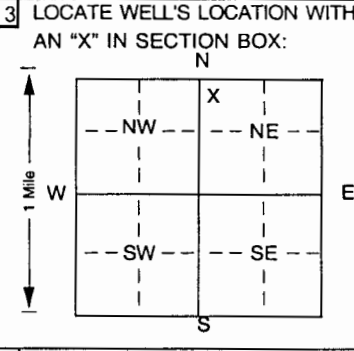

4 DEPTH OF COMPLETED WELL: 57 ft. ELEVATION: unknown

Depth(s) Groundwater Encountered 1 ft. 2 ft. 3 ft. ft.

WELL'S STATIC WATER LEVEL: 22 ft. below land surface measured on mo/day/yr 6-17-05

Pump test data: Well water was not checked ft. after hours pumping gpm

Est. Yield unknown gpm: Well water was ft. after hours pumping gpm

Bore Hole Diameter: 24 in. to 56 ft., and in. to ft.

WELL WATER TO BE USED AS:

5 Public water supply	8 Air conditioning	11 Injection well
1 Domestic	3 Feedlot	6 Oil field water supply
2 Irrigation	4 Industrial	7 Domestic (lawn & garden)
		10 Monitoring well

12 Other (specify below)

Was a chemical/bacteriological sample submitted to Department? Yes No If yes, mo/day/yr sample was submitted

Water Well Disinfected? Yes No

5 TYPE OF BLANK CASING USED:

1 Steel	3 RMP (SR)	5 Wrought iron	8 Concrete tile	CASING JOINTS: Glued <input checked="" type="checkbox"/> Clamped
2 PVC	4 ABS	6 Asbestos-Cement	9 Other (specify below)	Welded
		7 Fiberglass		Threaded

Blank casing diameter: 12 in. to 38 ft., Dia in. to ft., Dia in. to ft.

Casing height above land surface: 24 in., weight 10.31 lbs./ft. Wall thickness or gauge No. 420

TYPE OF SCREEN OR PERFORATION MATERIAL:

1 Steel	3 Stainless steel	5 Fiberglass	8 RMP (SR)	10 Asbestos-cement
2 Brass	4 Galvanized steel	6 Concrete tile	9 ABS	11 Other (specify)
				12 None used (open hole)

SCREEN OR PERFORATION OPENINGS ARE:

1 Continuous slot	3 Mill slot	5 Gauzed wrapped	8 Saw cut	11 None (open hole)
2 Louvered shutter	4 Key punched	6 Wire wrapped	9 Drilled holes	
		7 Torch cut	10 Other (specify)	

SCREEN-PERFORATED INTERVALS: From 38 ft. to 55 ft., From ft. to ft.

GRAVEL PACK INTERVALS: From 21 ft. to 56 ft., From ft. to ft.

6 GROUT MATERIAL: 1 Neat cement 2 Cement grout 3 Bentonite 4 Other

Grout Intervals: From 0 ft. to 21 ft., From ft. to ft., From ft. to ft.

What is the nearest source of possible contamination:

1 Septic tank	4 Lateral lines	7 Pit privy	10 Livestock pens	14 Abandoned water well
2 Sewer lines	5 Cess pool	8 Sewage lagoon	11 Fuel storage	15 Oil well/Gas well
3 Watertight sewer lines	6 Seepage pit	9 Feedyard	12 Fertilizer storage	16 Other (specify below)
			13 Insecticide storage	None known

Direction from well? How many feet?

FROM	TO	LITHOLOGIC LOG	FROM	TO	PLUGGING INTERVALS
0	3	Topsoil			
3	6	Clay, brown			
6	13	Sand and gravel, fine, medium			
13	23	Sand and gravel, fine, medium with broken shale			
23	48	Sand and gravel, fine, medium, coarse with broken shale			
48	51	Clay, reddish brown			
51	54	Sand and gravel, fine, medium with broken shale			
54	55	Sand and gravel, fine, medium, coarse with broken shale			
55	56	Shale			

7 CONTRACTOR'S OR LANDOWNER'S CERTIFICATION: This water well was (1) constructed (2) reconstructed, or (3) plugged under my jurisdiction and was completed on (mo/day/year) 6-17-05 and this record is true to the best of my knowledge and belief. Kansas Water Well Contractor's License No 185 This Water Well Record was completed on (mo/day/yr) 6-24-05 under the business name of Clarke Well & Equipment, Inc. by (signature) *Clarke Well & Equipment*