


1 LOCATION OF WATER WELL: Harper	FRACTION SW 1/4 SE 1/4 SE 1/4	Section Number 8	Township Number T 31 S	Range Number R 6W E/W
--	---	----------------------------	----------------------------------	---------------------------------

Distance and direction from nearest town or city street address of well if located within city?

1/4 W. of Adams, KS., 7 m. S. of Hwy 42, 1/4 W. on N.E. 140 Rd., N. side

WATER WELL OWNER: LA COUNT, Kim RR#, ST. ADDRESS, BOX #: 274 N.E. 140th Road CITY, STATE, ZIP CODE: Harper, Kansas	Harper, KS Board of Agriculture, Division of Water Resource Application Number:
---	---

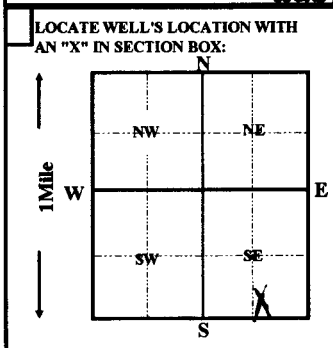

4 DEPTH OF COMPLETED WELL	97	ft.	ELEVATION:		
Depth(s) groundwater Encountered	1	ft.	2	ft.	3
WELL'S STATIC WATER LEVEL	35	FT. BELOW LAND SURFACE MEASURED ON	06/12/1996	mo/day/yr	
Pump test data:	Well water was	ft.	after	hours pumping	gpm
Est. Yield	30	gpm:	Well water was	ft.	after
Bore Hole Diameter	12	in. to	97	ft. and	in. to
WELL WATER TO BE USED AS:	5	Public water supply	8	Air conditioning	11
	1	Domestic	3	Feedlot	6
	2	Irrigation	4	Industrial	7
			7	Lawn and garden only	10
			8	Oil field water supply	9
			9	Dewatering	12
			10	Monitoring well	
Was a chemical/bacteriological sample submitted to Department? Yes No <input checked="" type="checkbox"/> ; If yes, mo/day/yr sample was submitted					
Water Well Disinfected? Yes <input checked="" type="checkbox"/> No					

5 TYPE OF CASING USED:	1 Steel	3 RMP (SR)	5 Wrought iron	8 Concrete tile	CASING JOINTS:	Glued <input checked="" type="checkbox"/>	Clamped
	2 PVC	4 ABS	6 Asbestos-Cement	9 Other (Specify below)		Welded	
			7 Fiberglass	SDR-26		Threaded	
Blank casing Diameter	5	in. to	35	ft., Dia	in. to	ft., Dia	in. to
Casing height above land surface	12	in.,	weight	2.35	lbs. / ft.	Wall thickness or gauge No.	.214
TYPE OF SCREEN OR PERFORATION MATERIAL:							
	1 Steel	3 Stainless Steel	5 Fiberglass	8 RMP (SR)	10 Asbestos-cement	11 other (specify)	
	2 Brass	4 Galvanized steel	6 Concrete tile	9 ABS	12 None used (open hole)		
SCREEN OR PERFORATION OPENING ARE:							
	1 Continuous slot	3 Mill slot	5 Gauzed wrapped	8 Saw cut	11 None (open hole)		
	2 Louvered shutter	4 Key punched	6 Wire wrapped	9 Drilled holes			
			7 Torch cut	10 Other (specify)			
SCREEN-PERFORATION INTERVALS:							
	from	35	ft. to	97	ft., From	ft. to	ft.
			ft. to		ft., From	ft. to	ft.
GRAVEL PACK INTERVALS:							
	from	24	ft. to	97	ft., From	ft. to	ft.
			ft. to		ft., From	ft. to	ft.

6 GROUT MATERIAL:	1 Neat cement	2 Cement grout	3 Bentonite	4 Other			
GROUT INTERVALS:	From 4	ft. to	24	ft. From	ft. to	ft. From	ft. to
What is the nearest source of possible contamination:							
	1 Septic tank	4 Lateral lines	7 Pit privy	10 Livestock pens	14 Abandon water well		
	2 Sewer lines	5 Cess pool	8 Sewage lagoon	11 Fuel storage	15 Oil well/Gas well		
	3 Watertight sewer lines	6 Seepage pit	9 Feedyard	12 Fertilizer storage	16 Other (specify below)		
				13 Insecticide storage	None Apparent		
Direction from well? How many feet?							

FROM	TO	LITHOLOGIC LOG	FROM	TO	PLUGGING INTERVALS
0	3	topsoil			
3	17	clay			
17	97	red shale			

7	CONTRACTOR'S OR LANDOWNER'S CERTIFICATION: This water well was (1) constructed, (2) reconstructed, or (3) plugged under my jurisdiction and was completed on (mo/day/year) 06/12/1996 and this record is true to the best of my knowledge and belief. Kansas Water Well Contractor's License No. 236 This Water Well Record was completed on (mo/day/yr)..... 06/13/96 Under the business name of Harp Well & Pump Service, Inc by (signature) <div style="text-align: right; margin-top: 10px;"><i>Todd S. Harp</i></div>
---	--