


1 LOCATION OF WATER WELL: County: Harper Fraction: SE 1/4 NE 1/4 NE 1/4 Section Number: 17 Township Number: T 31 S Range Number: R 6 EW

Distance and direction from nearest town or city street address of well if located within city?

3 1/2 miles NE Harper

2 WATER WELL OWNER: Barbara New Som
 RR#, St. Address, Box #: Harper, Kan 67058
 City, State, ZIP Code: Harper, Kan 67058
 Board of Agriculture, Division of Water Resources
 Application Number:

3 LOCATE WELL'S LOCATION WITH AN "X" IN SECTION BOX:
 4 DEPTH OF COMPLETED WELL: 70 ft. ELEVATION: 62 ft.
 Depth(s) Groundwater Encountered: 17 ft. 40 ft. 62 ft.
 WELL'S STATIC WATER LEVEL: 17 ft. below land surface measured on mo/day/yr: 3-1-82

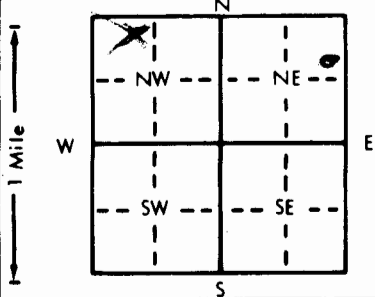

Pump test data: Well water was _____ ft. after _____ hours pumping _____ gpm
 Est. Yield: 10 gpm; Well water was _____ ft. after _____ hours pumping _____ gpm
 Bore Hole Diameter: 8 in. to 70 ft., and _____ in. to _____ ft.
 WELL WATER TO BE USED AS:
 1 Domestic 1 3 Feedlot 3 6 Oil field water supply 6 9 Dewatering 9 12 Other (Specify below)
 2 Irrigation 2 4 Industrial 4 7 Lawn and garden only 7 10 Observation well 10
 Was a chemical/bacteriological sample submitted to Department? Yes _____ No No; If yes, mo/day/yr sample was submitted _____
 Water Well Disinfected? Yes _____ No _____

5 TYPE OF BLANK CASING USED:
 1 Steel 5 3 RMP (SR) 3 6 Asbestos-Cement 6 9 Other (specify below) _____
 2 PVC 2 4 ABS 4 7 Fiberglass _____
 Blank casing diameter: 5 in. to 30 ft., Dia _____ in. to _____ ft., Dia _____ in. to _____ ft.
 Casing height above land surface: 18 in., weight _____ lbs./ft. Wall thickness or gauge No. 265

TYPE OF SCREEN OR PERFORATION MATERIAL:
 1 Steel 1 3 Stainless steel 3 5 Fiberglass 5 8 RMP (SR) 8 11 Other (specify) _____
 2 Brass 2 4 Galvanized steel 4 6 Concrete tile 6 9 ABS 9 12 None used (open hole) 12

SCREEN OR PERFORATION OPENINGS ARE:
 1 Continuous slot 1 3 Mill slot 3 5 Gauzed wrapped 5 8 Saw cut 8 11 None (open hole) 11
 2 Louvered shutter 2 4 Key punched 4 6 Wire wrapped 6 9 Drilled holes 9
 7 Torch cut 7 10 Other (specify) _____

SCREEN-PERFORATED INTERVALS: From _____ ft. to _____ ft., From _____ ft. to _____ ft.
 GRAVEL PACK INTERVALS: From 13 ft. to 30 ft., From _____ ft. to _____ ft.

6 GROUT MATERIAL: 1 Neat cement 1 2 Cement grout 2 3 Bentonite 3 4 Other _____
 Grout intervals: From 3 ft. to 13 ft., From _____ ft. to _____ ft., From _____ ft. to _____ ft.
 What is the nearest source of possible contamination:
 1 Septic tank 1 4 Lateral lines 4 7 Pit privy 7 10 Livestock pens 10 14 Abandoned water well 14
 2 Sewer lines 2 5 Cess pool 5 8 Sewage lagoon 8 11 Fuel storage 11 15 Oil well/Gas well 15
 3 Watertight sewer lines 3 6 Seepage pit 6 9 Feedyard 9 12 Fertilizer storage 12 16 Other (specify below) _____
 13 Insecticide storage 13
 Direction from well? SW How many feet? 60

FROM	TO	LITHOLOGIC LOG	FROM	TO	LITHOLOGIC LOG
0	4	Soil			
4	8	Fine sand			
8	12	Clay			
12	14	Sand			
14	15	Coarse sand			
15	70	Shale			

7 CONTRACTOR'S OR LANDOWNER'S CERTIFICATION: This water well was (1) constructed, (2) reconstructed, or (3) plugged under my jurisdiction and was completed on (mo/day/year) 3-1-82 and this record is true to the best of my knowledge and belief. Kansas Water Well Contractor's License No. 140 This Water Well Record was completed on (mo/day/yr) 3-27-82 under the business name of Lyman Bros by (signature) Richard Lyman

INSTRUCTIONS: Use typewriter or ball point pen, PLEASE PRESS FIRMLY and PRINT clearly. Please fill in blanks, underline or circle the correct answers. Send top three copies to Kansas Department of Health and Environment, Division of Environment, Environmental Geology Section, Topeka, KS 66620. Send one to WATER WELL OWNER and retain one for your records.

OFFICE USE ONLY
T
R
6
SEC.
17
SE 1/4
NE 1/4