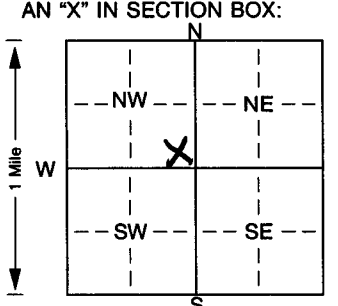


1 LOCATION OF WATER WELL: Fraction SE 1/4 SE 1/4 NW 1/4 Section Number 3 Township Number T 31 S Range Number R 6 E
 County: HARPER

Distance and direction from nearest town or city street address of well if located within city?

2 WATER WELL OWNER: PLUMB THICKET FARM
 RR#, St. Address, Box #: S180 RD.
 City, State, ZIP Code: HARPER, KS 67058
 Board of Agriculture, Division of Water Resources
 Application Number:

3 LOCATE WELL'S LOCATION WITH AN "X" IN SECTION BOX:

 4 DEPTH OF COMPLETED WELL: ft. ELEVATION:
 Depth(s) Groundwater Encountered 1. 30.37 ft. 2. 30.37 ft. 3. 41.5/02 ft.
 WELL'S STATIC WATER LEVEL 30.37 ft. below land surface measured on mo/day/yr 4/15/02
 Pump test data: Well water was 0.7 ft. after 10 hours pumping 5 gpm
 Est. Yield 5 gpm: Well water was 10 ft. after 5 hours pumping 50 gpm
 Bore Hole Diameter: 0.7 in. to 10 ft., and 5 in. to 50 ft.
 WELL WATER TO BE USED AS:
 1 Domestic 2 Irrigation 3 Feedlot 4 Industrial 5 Public water supply 6 Oil field water supply 7 Domestic (lawn & garden) 8 Air conditioning 9 Dewatering 10 Monitoring well 11 Injection well 12 Other (Specify below)

5 TYPE OF BLANK CASING USED:
 1 Steel 2 PVC 3 RMP (SR) 4 ABS 5 Wrought iron 6 Asbestos-Cement 7 Fiberglass 8 Concrete tile 9 Other (specify below) CASING JOINTS: Glued. Clamped. Welded. Threaded.
 Blank casing diameter 2 in. to 24 ft., Dia. 25 lbs./ft. Wall thickness or gauge No. 14
 Casing height above land surface 36 in., weight 25 lbs./ft.
 TYPE OF SCREEN OR PERFORATION MATERIAL:
 1 Steel 2 Brass 3 Stainless steel 4 Galvanized steel 5 Fiberglass 6 Concrete tile 7 RVC 8 RMP (SR) 9 ABS 10 Asbestos-cement 11 Other (specify) 12 None used (open hole)
 SCREEN OR PERFORATION OPENINGS ARE:
 1 Continuous slot 2 Louvered shutter 3 Mill slot 4 Key punched 5 Gauzed wrapped 6 Wire wrapped 7 Torch cut 8 Saw cut 9 Drilled holes 10 Other (specify) 11 None (open hole)

 What is the nearest source of possible contamination:
 1 Septic tank 2 Sewer lines 3 Watertight sewer lines 4 Lateral lines 5 Cess pool 6 Seepage pit 7 Pit privy 8 Sewage lagoon 9 Feedyard 10 livestock pens 11 Fuel storage 12 Fertilizer storage 13 Insecticide storage 14 Abandoned water well 15 Oil well/Gas well 16 Other (specify below)
 Direction from well? WHOLE SITE USE TO BE How many feet?

FROM	TO	LITHOLOGIC LOG	FROM	TO	PLUGGING INTERVALS
0.0	1.0	TOPSOIL			
1.0	2	RED SILTY CLAY			
2	50	RED SILTSTONE			
		BUFF 50.0			

7 CONTRACTOR'S OR LANDOWNER'S CERTIFICATION: This water well was (1) constructed, (2) reconstructed, or (3) plugged under my jurisdiction and was completed on (mo/day/year) 3/25/02 and this record is true to the best of my knowledge and belief. Kansas Water Well Contractor's Licence No. 702 This Water Well Record was completed on (mo/day/yr) 4-15-02 under the business name of BOWSER-MORNER by (signature) Tim Bowser