


Well # P2-31

LOCATION OF WATER WELL: County: Harper Fraction: NW 1/4 SW 1/4 NW 1/4 Section Number: 3 Township Number: T 31 S Range Number: R 6 E (NW)

Distance and direction from nearest town or city street address of well if located within city? 2 mi. NE of Harper, then 5 mi N on Murdock Rd. to SE 180th St., turn (R) 1 mi.

WATER WELL OWNER: Waste Connections, Inc
 R#, St. Address, Box #: 4625 South Rockwell
 City, State, ZIP Code: Oklahoma City, OK 73179
 Board of Agriculture, Division of Water Resources
 Application Number:

LOCATE WELL'S LOCATION WITH AN "X" IN SECTION BOX: DEPTH OF COMPLETED WELL: 15.5 ft. ELEVATION: _____ ft.

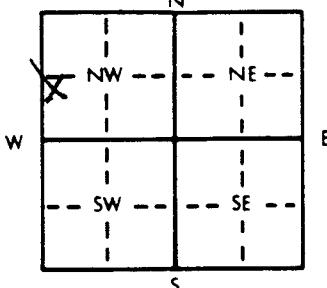

Depth(s) Groundwater Encountered 1. _____ ft. 2. _____ ft. 3. _____ ft.
 WELL'S STATIC WATER LEVEL: 13.67 ft. below land surface measured on mo/day/yr 4/23/02
 Pump test data: Well water was _____ ft. after _____ hours pumping _____ gpm
 Est. Yield: 51 gpm; Well water was _____ ft. after _____ hours pumping _____ gpm
 Bore Hole Diameter: 8 in. to 17.5 ft., and _____ in. to _____ ft.
 WELL WATER TO BE USED AS:
 5 Public water supply 8 Air conditioning 11 Injection well
 1 Domestic 3 Feedlot 6 Oil field water supply 9 Dewatering 12 Other (Specify below)
 2 Irrigation 4 Industrial 7 Lawn and garden only 10 Monitoring well
 Was a chemical/bacteriological sample submitted to Department? Yes _____ No _____; If yes, mo/day/yr sample was submitted _____
 Water Well Disinfected? Yes _____ No

TYPE OF BLANK CASING USED:
 1 Steel 3 RMP (SR) 5 Wrought iron 8 Concrete tile CASING JOINTS: Glued _____ Clamped _____
 2 PVC 4 ABS 6 Asbestos-Cement 9 Other (specify below) Welded _____
 7 Fiberglass Threaded:
 Blank casing diameter: 2 in. to 15.5 ft., Dia _____ in. to _____ ft., Dia _____ in. to _____ ft.
 Casing height above land surface: 30 in., weight _____ lbs./ft. Wall thickness or gauge No. Sch. 40

TYPE OF SCREEN OR PERFORATION MATERIAL:
 1 Steel 3 Stainless steel 5 Fiberglass 8 RMP (SR) 10 Asbestos-cement
 2 Brass 4 Galvanized steel 6 Concrete tile 9 ABS 11 Other (specify) _____
 12 None used (open hole)

SCREEN OR PERFORATION OPENINGS ARE:
 1 Continuous slot 3 Mill slot 5 Gauzed wrapped 8 Saw cut 11 None (open hole)
 2 Louvered shutter 4 Key punched 6 Wire wrapped 9 Drilled holes
 7 Torch cut 10 Other (specify) _____

SCREEN-PERFORATED INTERVALS: From 10.5 ft. to 15.5 ft., From _____ ft. to _____ ft.
 From _____ ft. to _____ ft., From _____ ft. to _____ ft.
 GRAVEL PACK INTERVALS: From 8 ft. to 17.5 ft., From _____ ft. to _____ ft.
 From _____ ft. to _____ ft., From _____ ft. to _____ ft.

GROUT MATERIAL: 1 Neat cement 2 Cement grout 3 Bentonite 4 Other _____
 Grout Intervals: From 6 ft. to 8 ft., From 0 ft. to 6 ft., From _____ ft. to _____ ft.

What is the nearest source of possible contamination: (None observed.)
 1 Septic tank 4 Lateral lines 7 Pit privy 10 Livestock pens 14 Abandoned water well
 2 Sewer lines 5 Cess pool 8 Sewage lagoon 11 Fuel storage 15 Oil well/Gas well
 3 Watertight sewer lines 6 Seepage pit 9 Feedyard 12 Fertilizer storage 16 Other (specify below)
 13 Insecticide storage

Direction from well? _____ How many feet? _____

FROM	TO	LITHOLOGIC LOG	FROM	TO	PLUGGING INTERVALS
<u>0</u>	<u>3</u>	<u>Silt</u>			
<u>3</u>	<u>15.5</u>	<u>SAND VARYING FROM WELL GRADE TO POOR GRADED SILTY</u>			
<u>15.5</u>	<u>17</u>	<u>COMPLETELY WEATHERED SILTSTONE</u>			
<u>17</u>	<u>18</u>	<u>SILTSTONE</u>			

CONTRACTOR'S OR LANDOWNER'S CERTIFICATION: This water well was (1) constructed, (2) reconstructed, or (3) plugged under my jurisdiction and was completed on (mo/day/year) 5/10/02 and this record is true to the best of my knowledge and belief. Kansas Water Well Contractor's License No. 553 This Water Well Record was completed on (mo/day/yr) 4-3-02 under the business name of A.W. Poole, Inc. by (signature) Keith Poole