


LOCATION OF WATER WELL: Fraction *NW 1/4 SE 1/4 SE 1/4* Section Number *3* Township Number *T 31 S* Range Number *R 6 EW*
 County: *Harper*
 Distance and direction from nearest town or city street address of well if located within city?
2 mi. NE of Harper, KS then 5 mi N. on MURDOCK Rd to SE 180th St, then (R) for 1 mi.
 WATER WELL OWNER: *Waste CONNECTIONS, INC.*
 R#, St. Address, Box #: *4625 South Rockwell*
 City, State, ZIP Code: *OKLAHOMA City OK 73179*
 Board of Agriculture, Division of Water Resources
 Application Number:

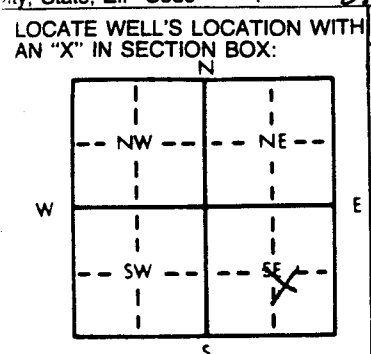

DEPTH OF COMPLETED WELL: *26* ft. ELEVATION:
 Depth(s) Groundwater Encountered 1. *17.2* ft. 2. ft. 3. ft.
 WELL'S STATIC WATER LEVEL *21.7* ft. below land surface measured on *mo/day/yr 4-23-02*
 Pump test data: Well water was ft. after hours pumping gpm
 Est. Yield *21* gpm: Well water was ft. after hours pumping gpm
 Bore Hole Diameter *8* in. to *26* ft. and in. to ft.
 WELL WATER TO BE USED AS:
 5 Public water supply 8 Air conditioning 11 Injection well
 1 Domestic 3 Feedlot 6 Oil field water supply 9 Dewatering
 2 Irrigation 4 Industrial 7 Lawn and garden only 10 Monitoring well *PERMETER*
 Was a chemical/bacteriological sample submitted to Department? Yes No: If yes, mo/day/yr sample was submitted
 Water Well Disinfected? Yes No

TYPE OF BLANK CASING USED:
 1 Steel 3 RMP (SR) 5 Wrought iron 8 Concrete tile CASING JOINTS: Glued Clamped
 2 PVC 4 ABS 7 Fiberglass Welded
 Blank casing diameter *2* in. to *16* ft. Dia in. to ft. Dia in. to ft.
 Casing height above land surface *30* in., weight lbs./ft. Wall thickness or gauge No. *Sch 40*

TYPE OF SCREEN OR PERFORATION MATERIAL:
 1 Steel 3 Stainless steel 5 Fiberglass 8 RMP (SR) 10 Asbestos-cement
 2 Brass 4 Galvanized steel 6 Concrete tile 9 ABS 11 Other (specify)
 12 None used (open hole)

SCREEN OR PERFORATION OPENINGS ARE:
 1 Continuous slot 3 Mill slot 5 Gauzed wrapped 8 Saw cut 11 None (open hole)
 2 Louvered shutter 4 Key punched 6 Wire wrapped 9 Drilled holes
 7 Torch cut 10 Other (specify)

SCREEN-PERFORATED INTERVALS: From *16* ft. to *26* ft. From ft. to ft.
 GRAVEL PACK INTERVALS: From *14* ft. to *26* ft. From ft. to ft.

GROUT MATERIAL: 1 Neat cement 2 Cement grout 3 Bentonite 4 Other
 Grout Intervals: From *3* ft. to *14* ft. From *0* ft. to *12* ft. From ft. to ft.

What is the nearest source of possible contamination: *(None)*
 1 Septic tank 4 Lateral lines 7 Pit privy 10 Livestock pens 14 Abandoned water well
 2 Sewer lines 5 Cess pool 8 Sewage lagoon 11 Fuel storage 15 Oil well/Gas well
 3 Watertight sewer lines 6 Seepage pit 9 Feedyard 12 Fertilizer storage 16 Other (specify below)
 13 Insecticide storage

Direction from well? How many feet?

FROM	TO	LITHOLOGIC LOG	FROM	TO	PLUGGING INTERVALS
<i>0</i>	<i>5</i>	<i>site</i>			
<i>5</i>	<i>11</i>	<i>completely weathered siltstone</i>			
<i>11</i>	<i>26.2</i>	<i>siltstone</i>			

CONTRACTOR'S OR LANDOWNER'S CERTIFICATION: This water well was *(1)* constructed, (2) reconstructed, or (3) plugged under my jurisdiction and was completed on (mo/day/year) *5/10/02* and this record is true to the best of my knowledge and belief. Kansas Water Well Contractor's License No. *555* This Water Well Record was completed on (mo/day/yr) *4-23-02* under the business name of *A.W. POOL, INC.* by (signature) *Keith*