


1 LOCATION OF WATER WELL:	Fraction	Section Number	Township Number	Range Number
County: <u>Harper</u>	<u>SW ¼ NW ¼ SW ¼</u>	<u>3</u>	<u>31</u>	<u>6 E</u> W

Distance and direction from nearest town or city street address of well if located within city?
Plumb Thicket Landfill

2	WATER WELL OWNER: <u>Waste Connections</u> <u>2745 N. Ohio</u>	Board of Agriculture, Division of Water Resources
	RR #, St. Address, Box #: <u>Wichita, KS 67219</u>	Application Number: _____
	City, State, ZIP Code :	

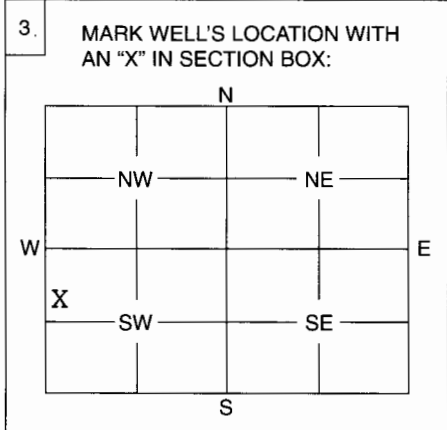

4. DEPTH OF WELL 40.15 ft.
 WELL'S STATIC WATER LEVEL 28.37 ft.

WELL WAS USED AS:

1 Domestic	5 Public Water Supply	9 Dewatering
2 Irrigation	6 Oil Field Water Supply	10 Monitoring Well
3 Feedlot	7 Domestic (Lawn & Garden)	11 Injection Well
4 Industrial	8 Air Conditioning	12 Other

Was a chemical / bacteriological sample submitted to Department? Yes No X.....
 If yes, mo/day/yr sample was submitted

Water Well Disinfected: Yes No X.....

5. TYPE OF BLANK CASING USED:

1 Steel	3 RMP (SR)	5 Wrought	7 Fiberglass	9 Other (Specify below)
2 PVC	4 ABS	6 Asbestos-Cement	8 Concrete Tile

Blank casing diameter 2 in. Was casing pulled? Yes X No If yes, how much 10.1.....
 Casing height above or below land surface 29 in.

6. GROUT PLUG MATERIAL: 1 Neat cement 2 Cement grout 3 Bentonite 4 Other

Grout Plug Intervals: From 47 ft. to 3 ft., From 3 ft. to 0 ft., From to ft.

What is the nearest source of possible contamination:

1 Septic tank	6 Seepage pit	11 Fuel storage	12 Other (specify below)
2 Sewer lines	7 Pit privy	12 Fertilizer storage	<u>Located in new</u>
3 Watertight sewer lines	8 Sewage lagoon	13 Insecticide storage	<u>landfill</u>
4 Lateral lines	9 Feedyard	14 Abandoned water well	
5 Cess pool	10 Livestock pens	15 Oil well/Gas well	

Direction from well? 999 How many feet? 999

FROM	TO	PLUGGING MATERIALS
47	3	Bentonite Grout
3	0	Clay and top soil

PZ9

7. CONTRACTOR'S OF LANDOWNER'S CERTIFICATION: This water well was plugged under my jurisdiction and was completed on (mo/day/year) 10-13-05 and this record is true to the best of my knowledge and belief. Kansas Water Well Contractor's License No. 665. This Water Well Record was completed on (mo/day/year) 10-14-05 under the business name of Pratt Well Environmental by (signature) [Signature]

INSTRUCTIONS: Use typewriter or ball point pen. Please press firmly and print clearly. Please fill in blanks, underline or circle the correct answers. Send top three copies to Kansas Department of Health and Environment, Bureau of Water, Geology Section, 1000 SW Jackson St., Ste. 420, Topeka, Kansas 66612-1367. Telephone: 785/296-5522. Send one to Water Well Owner and retain one for your records.